

CENTRAL MAPPING AUTHORITY
Department of Lands

Trigonometrical Survey of N.S.W.

RECONNAISSANCE and MAINTENANCE REPORT

This Trig. Station has been:-

Note: Cross out word or words which do not apply

1. Completely cleared to permit 360° vision to surrounding Trigs. ✓
2. Cleared by lines bearing 360° vision from Trig. Mast
3. Trig. Mast & Vanes have been painted white & black respectively.
4. The Trig. was supplied not unpiled, dimensions now being:

Description of mark..... should be explicit, e.g. Steel plug, Brass plug, Bolt, G.I. Pipe

Height of mark..... m above rock/concrete..... m G.L.

Height of Top Vanes to Top Mark..... m. Diameter of Vanes (vertical) 0.614 m.

Height of Cairn 1.6m m. Diameter of Cairn 1.4m m.

Length of Mast 3.61 m m. (approximate if not unpiled)

5. A 6" Nail set in conc/soil has been placed 13.28 m. bearing 136°M from Trig. Mast

6. A..... set in conc/soil has been placed..... m. bearing.....°M from Trig. Mast

7. A..... set in conc/soil has been placed..... m. bearing.....°M from Trig. Mast

8. A..... set in conc/rock has been placed..... m. bearing.....°M from Trig. Mast

9. Connection..... to..... m. bearing.....°M

10. Connection..... to..... m. bearing.....°M

11. Connection..... to..... m. bearing.....°M

12. Connection..... to..... m. bearing.....°M

13. Diff. Ht. 6" Nail in peg is 5.65 m. Bottom of vanes Bullenbalong G.S.

14. Diff. Ht. is..... m. above.....

15. Diff. Ht. is..... m. above.....

16. Diff. Ht. is..... m. above.....

Prepared by: A. Woodruff Checked: APR 2022 Noted on U.T.M. Card

7.45.91

STATION **BULLENBALONG G.S. 1244**

Co: **BERRIDALE** No: **8625**

Map Sheet: **BERRIDALE** No: **8625**

Inspected by: **A. WOODRUFF** Date: **21/1/77**

Authority: **C.M.A** Field Book: **1530**

Beacon Diagram Not to Scale


Date _____ Record of Station _____

STATION BULLENBALONG GS. 1244


Owners Name.....
 Current Occupant.....
 Address.....
 Address.....

Access 21-1-77
 0.0KMS.
 0.8KMS
 3.0KMS
 12.0KMS
 12.7KMS

BERRIDALE SHOPPING CENTRE.
 Turn left towards Adamaby
 and then immediately left onto dirt road
 signposted to Kiah Lodge.
 Take left fork.
 PASS Kiah Lodge.
 Take dirt track to property
 Reach sheds (refer to Diagram).

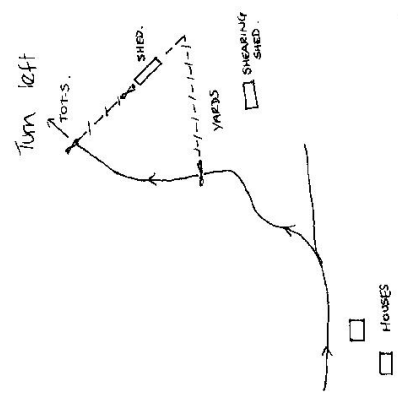

From shed head in general direction 235°M towards 135°
 Park vehicle and walk for about 15 minutes to
 Tng.

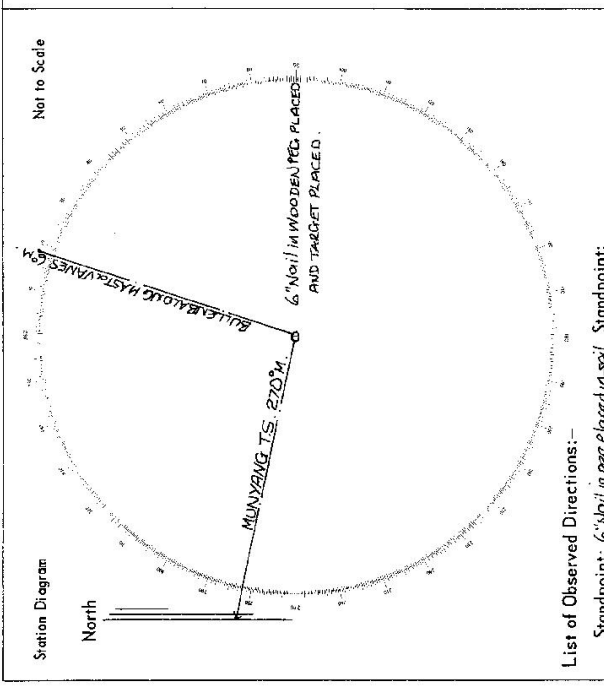

List of Observed Directions:-

Standpoint: 6" Nail in bag placed in soil Standpoint:

Station	Direction	Station	Direction
MUNYANG T.S.	08° 00' 00"		
BULLENBALONG LHS MAST	93° 02' 20"		
	93° 33' 42"		
Station	Direction	Station	Direction

14.5KMS