

GEODETTIC SURVEY OF N.S.W.

CENTRAL MAPPING AUTHORITY


GEODETTIC STATION RECONNAISSANCE and MAINTENANCE REPORT

STATION: **BULLIMBALLA** No.: **1251**

MAP SHEET SCALE 1:250 000 **TAMWORTH**

INSPECTED BY: DATE: FIELD BOOK:

AUTHORITY: **D.M.R.**

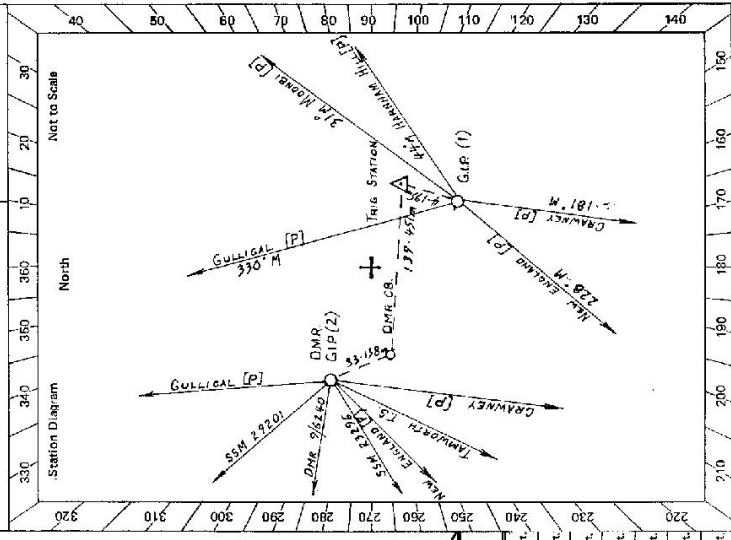

- Description: *Note: Cross out word or words which do not apply*
- Cleared by lanes bearing..... from Trig, Mast
 - ~~Mast & Vanes have been painted white & black respectively.~~
 - The station/pillar was ~~erected~~ ^{re-erected} on..... dimensions now being: should be explicit, e.g., S/Steel Pillar Plate, Steel plug, Brass plug, Bolt, G.I. Pipe
 - Description of mark.....
 - Height of mark.....m. ^{above} ~~below~~ rock ^{above} ~~below~~ eyes; Mark is.....m. ^{above} ~~below~~ G.L.
 - Height of Top Vanes to Top Mark/Pillar plate.....m. Diameter of Vanes (vertical).....m.
 - Height of Cairn.....m. Diameter of Cairn.....m. Name Plate found/not found/placed.
 - Length of Mast.....m. (approximate if not unplied)
 - A.....set in conc/rock has been placed/found, bearing.....°M from Mast/Plug/Pillar
 - A.....set in conc/rock has been placed/found, bearing.....°M from Mast/Plug/Pillar
 - A.....set in conc/rock has been placed/found, bearing.....°M from Mast/Plug/Pillar
 - A.....set in conc/rock has been placed/found, bearing.....°M from Mast/Plug/Pillar
 - Action required:.....

STANDPOINT: DMR CB.		STANDPOINT: BULLIMBALLA TRIG PLUG.	
Mark	Direction	Horiz. Distance	Height Difference
BULLIMBALLA TRIG	0° 00' 00"	139.451	above standpt.
DMR GIP (2)	214° 40' 12"	33.138	below standpt.
			above standpt.
			below standpt.
			above standpt.
			below standpt.
			above standpt.
			below standpt.
			above standpt.
			below standpt.

Prepared by: *[Signature]* Checked: **KEW BRIDGES** *Noted on U.T.M. Card*

