

7-2-08

Trigonometrical Survey of N.S.W.

CENTRAL MAPPING AUTHORITY

Department of Lands

RECONNAISSANCE and MAINTENANCE REPORT

STATION

BULLIO

1253

This Trig. Station has been:-

Note: Cross out word or words which do not apply

- 1. Completely cleared to permit 360° vision to surrounding Trigs. YES
- 2. Cleared by lanes bearing..... from Trig. Mast
- 3. Trig. Mast & Vanes have been painted white & black respectively. YES
- 4. The Trig. was ~~unpiled~~/not unpiled, dimensions now being:


Description of mark..... should be explicit, eg: Street plug, Brass plug, Bolt, G.I. Pipe

Height of mark..... m above rock/concrete..... m below G.L.
 Height of Top Vanes to Top Mark..... m Diameter of Vanes (vertical) 1.0 m.

Height of Cairn 1.4 m. Diameter of Cairn 2.0 m.
 1.4 m above cairn to bottom vanes

Length of Mast..... m. (approximate if not unpiled)

- 5. A...S.I.B.E...set in conc/rock has been placed 4.63 m. bearing 76 mag.°M from Trig. Mast
- 6. A...S.S.M. (no number)...set in conc/soil has been placed 5.35 m. bearing 34 f mag.°M from Trig. Mast
- 7. A.....set in conc/soil has been placed..... m. bearing.....°M from Trig. Mast
- 8. A.....set in conc/rock has been placed..... m. bearing.....°M from Trig. Mast
- 9. Connection.....to..... m. bearing.....°M
- 10. Connection.....to..... m. bearing.....°M
- 11. Connection.....to..... m. bearing.....°M
- 12. Connection.....to..... m. bearing.....°M
- 13. Diff. Ht. is..... m. above below
- 14. Diff. Ht. is..... m. above below
- 15. Diff. Ht. is..... m. above below
- 16. Diff. Ht. is..... m. above below

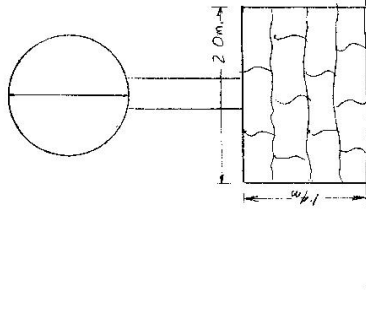

Beacon Diagram Not to Scale

Co: CAMDEN Ph: BULLIO

Map Sheet: BARRALLIER No: 8429-III-N

Inspected by: P. ETCELL Date: 30.7.75

Authority: A.T.C. Field Book:

Date

Record of Station

Prepared by: P. Etcell Checked: P. Etcell 23.8.75

Noted on U.T.M. Card

GEODETTIC SURVEY OF N.S.W.

CENTRAL MAPPING AUTHORITY

GEODETTIC STATION RECONNAISSANCE and MAINTENANCE REPORT

STATION: **BULLIO** No.: **253**

MAP SHEET SCALE 1:250 000 **Wollongong**


INSPECTED BY: **A. Sivertsen** DATE: **23-11-78**

AUTHORITY: **CMA** FIELD BOOK: **—**

- Description: *Note: Cross out word or words which do not apply*
1. Cleared by lanes bearing..... from Trig. Mast
 2. Mast & Vanes have been painted white & black respectively.
 3. The station/pillar was unpiled/not unpiled/constructed on..... 19....., dimensions now being: Description of mark..... should be explicit, e.g., S/Steel Pillar Plate, Steel plug, Brass plug, Bolt, G.I. Pipe Height of mark.....m. ^{above} rock/concrete; Mark/s.....m. ^{above} G.L.
 4. A.....m. Diameter of Top Vanes to Top Mark/Pillar plate.....m. Diameter of Vanes (vertical).....m.
 5. A.....m. Diameter of Cairn.....m. Name Plate found/not found/placed.
 6. Length of Mast.....m. (approximate if not unpiled)
 7. A.....set in conc./rock has been placed/found, bearing.....° M from Mast/Plug/Pillar
 8. A.....set in conc./rock has been placed/found, bearing.....° M from Mast/Plug/Pillar
 9. A.....set in conc./rock has been placed/found, bearing.....° M from Mast/Plug/Pillar
 10. A.....set in conc./rock has been placed/found, bearing.....° M from Mast/Plug/Pillar
 11. Action required:..... **BARRALLIER**

STANDPOINT: **1:25,000**

Mark	Direction	Horiz. Distance	Height Difference	Mark	Direction	Horiz. Distance	Height Difference
			above standpt.				above standpt.
			below				below
			above standpt.				above standpt.
			below				below
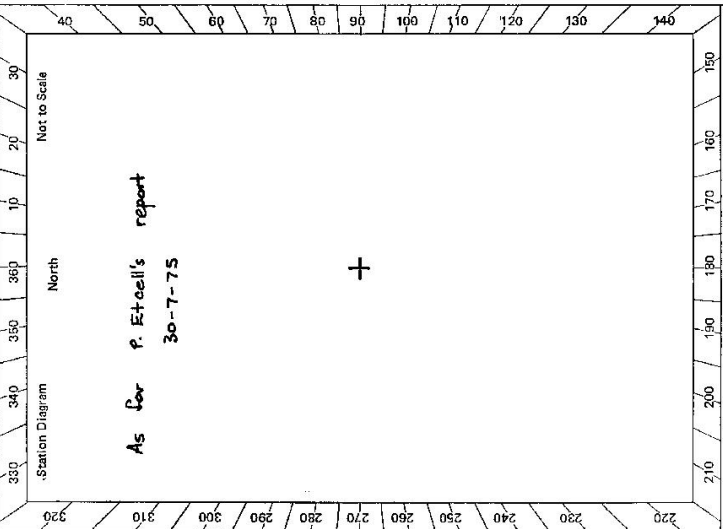

Prepared by: *Checked:*

Noted on U.T.M. Card

