

CENTRAL MAPPING AUTHORITY

GEODETIC SURVEY OF N.S.W.

GEODETIC STATION RECONNAISSANCE and MAINTENANCE REPORT


STATION: *BUNGARRABEE* No.: *1279*

MAP SHEET SCALE 1:250 000 *SYDNEY*

INSPECTED BY: *R. LAUREY* DATE: *28-9-81*

AUTHORITY: *C.M.A.* FIELD BOOK:

Description:
 1. Cleared by lanes bearing *S. 15° 15' 20" E. 22.53m* *FAK BUSH* *Note: Cross out word or words which do not apply*
 2. *Mast & Vanes have been painted white & black respectively.*
 3. The station/pillar was unplied/not unplied/constructed on..... 19....., dimensions now being:
 Description of mark..... should be explicit, e.g., S/Steel Pillar Plate, Steel plug, Brass plug, Bolt, G.I. Pipe
 Height of mark.....m. ^{above} _{below} rock/concrete; Mark is *0.2*.....m. ^{above} _{below} G.L.
 Height of Top Vanes to Top Mark/Pillar platem. Diameter of Vanes (vertical).....m.
 Height of Cairn.....m. Diameter of Cairn.....m. Name Plate found/not found/placed.
 Length of Mast.....m. (approximate if not unplied)
 4. A..... set in conc/rock has been placed/found, bearing.....° M from Mast/Plug/Pillar
 5. A..... set in conc/rock has been placed/found, bearing.....° M from Mast/Plug/Pillar
 6. A..... set in conc/rock has been placed/found, bearing.....° M from Mast/Plug/Pillar
 7. A..... set in conc/rock has been placed/found, bearing.....° M from Mast/Plug/Pillar
 8. Action required: *STATION TO BE SET AT 22.53m. STATION TO BE SET AT 22.53m. CONSTRUCTION OF STATION BY C.M.A. HIGH ROADS.*

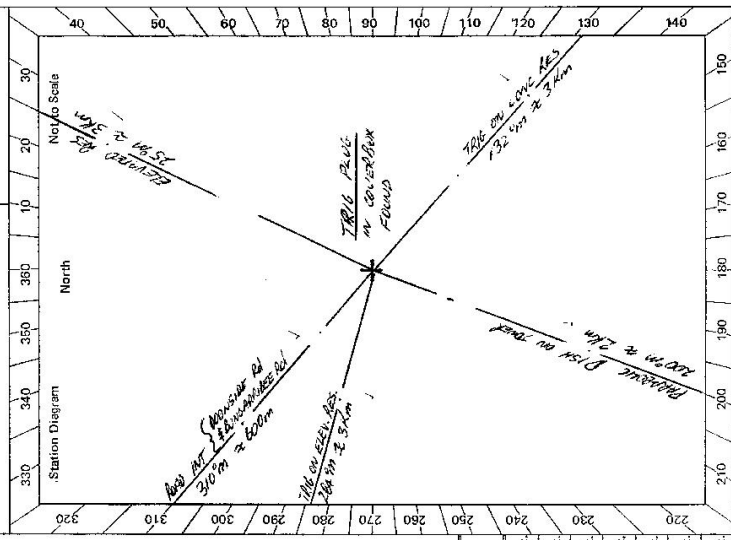


STANDPOINT:

Mark	Direction	Horiz. Distance	Height Difference	Mark	Direction	Horiz. Distance	Height Difference
			above standpt.				above standpt.
			below				below
			above standpt.				above standpt.
			below				below
Prepared by: *R. LAUREY* 7-10-81 Checked: *AS* Noted on U.T.M. Card

PM's and SSM's placed under Survey Practice Regulations 12 and 55B are required to have a Locality Sketch Plan lodged with the Deposited Plan at The Land Titles Office.

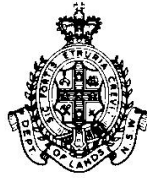


PM _____
 SSM _____
 Description TS BUNGARRIBEE
TS 1279

D.P. _____

LOCALITY SKETCH PLAN

Parish _____ County CUMBERLAND Town/Suburb/Locality DOONSIDE
 Municipality or Shire CITY OF BLACKTOWN C.M.A. Map Sheet ROOTY HILL 8260
 Measurements are in metres Zone 56 | 1

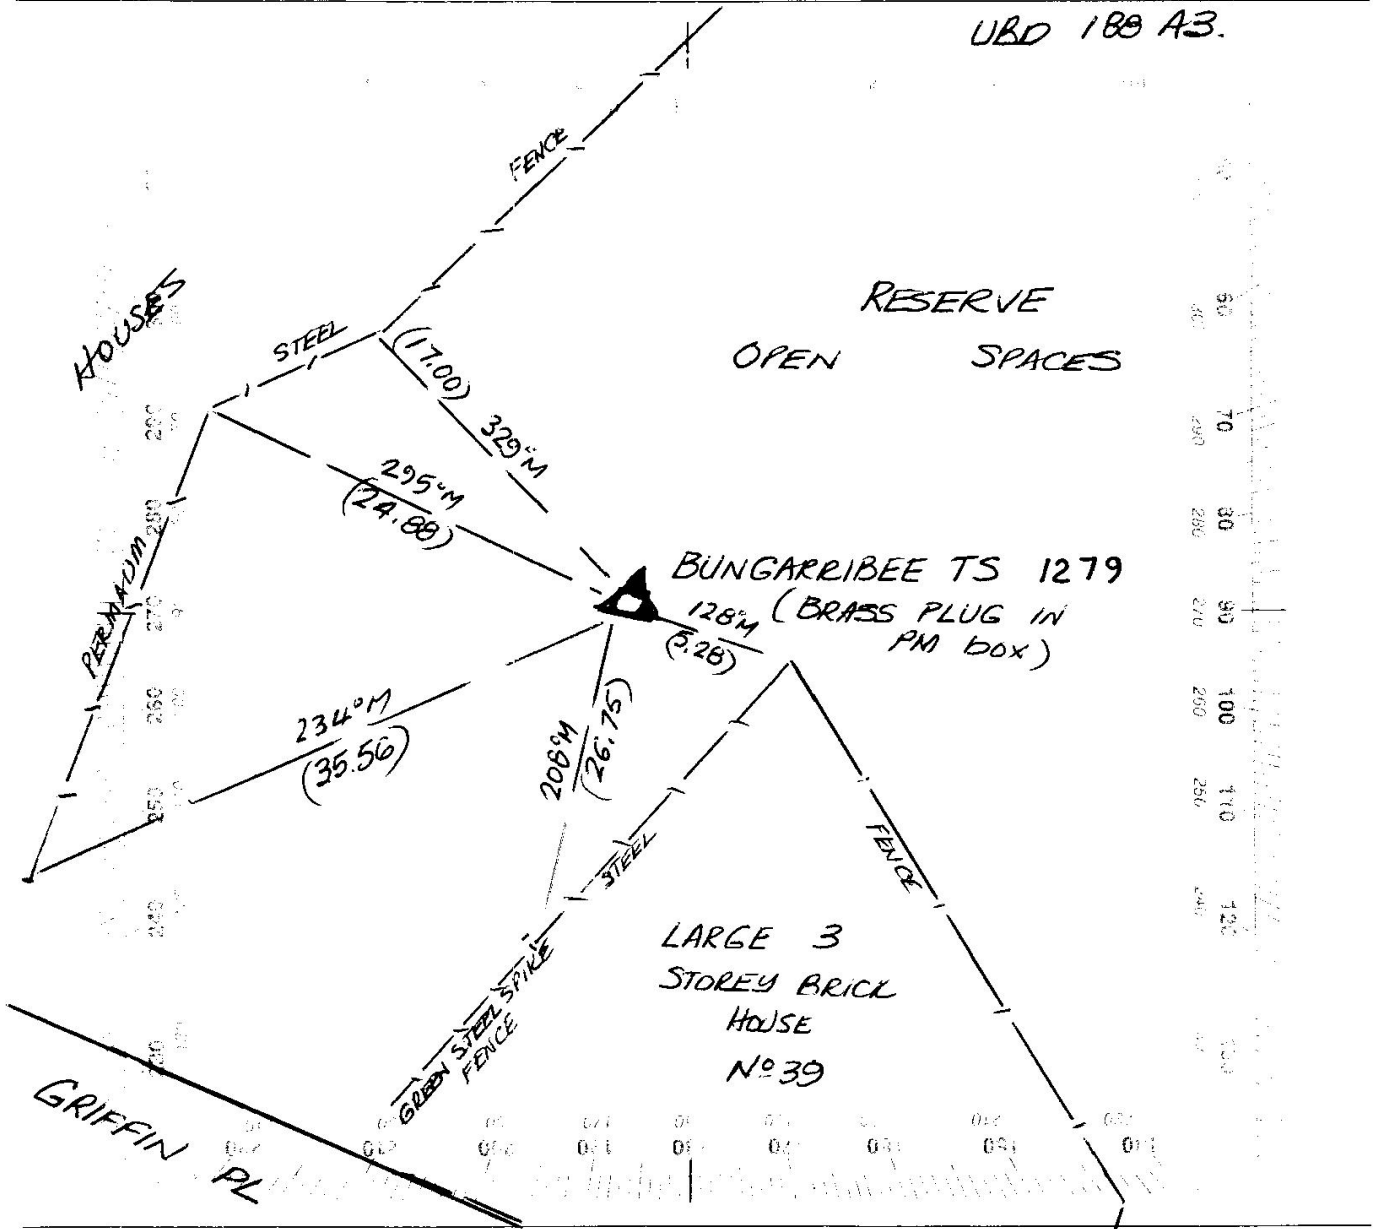

Organization placing Marks SCB

I certify that the Mark or Marks have been placed and numbered as detailed hereon.

Ref. _____
 The Surveyor General is to be notified of ISG/AMG Co-Ordinates and/or AHD Levels determined by survey for mark placed.

PM _____
 SSM _____
 Replaces PM _____
 SSM _____
 Signature: Juan Antonio
 Mark placed 15 / 2 / 1995