

7-4-98

CENTRAL MAPPING AUTHORITY

Department of Lands

Trigonometrical Survey of N.S.W.

RECONNAISSANCE and MAINTENANCE REPORT

STATION BUNGONGO

1284

This Trig. Station has been:-

Note: Cross out word or words which do not apply

1. Completely cleared to permit 360° vision to surrounding Trigs.

2. Cleared by lanes bearing..... from Trig. Mast

3. Trig. Mast & Vanes have been painted white & black respectively.

4. The Trig. was unpiled/not unpiled, dimensions now being:

Description of mark..... should be explicit, e.g. Steel plug, Brass plug, Bolt, G.I. Pipe

Height of mark..... m above rock/concrete

Height of Top Vanes to Top Mark..... m.

Height of Cairn..... m. Diameter of Cairn..... m.

Length of Mast..... m. (approximate if not unpiled)

5. A..... set in conc/rock has been placed..... m bearing.....°M from Trig. Mast

6. A..... set in conc/soil has been placed..... m bearing.....°M from Trig. Mast

7. A..... set in conc/soil has been placed..... m bearing.....°M from Trig. Mast

8. A..... set in conc/rock has been placed..... m bearing.....°M from Trig. Mast

9. Connection..... to..... m. bearing.....°M

10. Connection..... to..... m. bearing.....°M

11. Connection..... to..... m. bearing.....°M


12. Connection..... to..... m. bearing.....°M

13. Diff. Ht. is..... m. above below

14. Diff. Ht. is..... m. above below

15. Diff. Ht. is..... m. above below

16. Diff. Ht. is..... m. above below

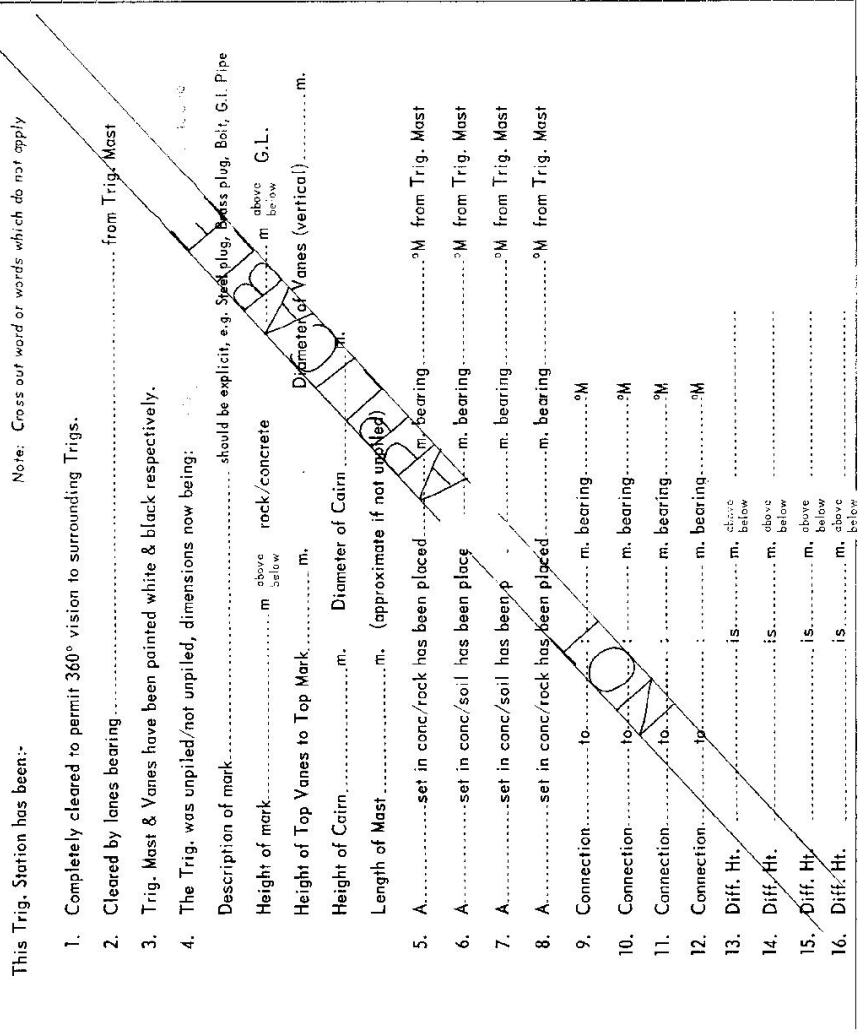

Co: BUCCLEUCH

Map Sheet: TUMUT

Inspected by G. C. HANNA

Authority

Beacon Diagram

Not to Scale

Date

Record of Station

Prepared by: G. Hanna

Noted on U.T.M. Card

Checked: 4/4

Checked

