

GEODETIC SURVEY OF N.S.W.

CENTRAL MAPPING AUTHORITY

GEODETIC STATION RECONNAISSANCE and MAINTENANCE REPORT

STATION: **BUNNAN WEST** No.: **1291**
 MAP SHEET SCALE 1:250 000 **SINGLETON**
 INSPECTED BY: **G.C. HANNA** DATE: **18/7/78**
 AUTHORITY: **C.W.A.** FIELD BOOK:

- Description:
- Note: *Cross out word or words which do not apply*
- Cleared by vanes bearing..... from Trig. Mast
 - Mast & Vanes have been painted white & black respectively.
 - The station/pillar was unpiled/not unpiled/constructed on..... 19....., dimensions now being: Description of mark..... should be explicit, e.g., S/Steel Pillar Plate, Steel plug, Brass plug, Bolt, G.I. Pipe
- Description of mark..... Mark is.....m. ^{above} _{below} G.L.
- Height of Top Vanes to Top Mark/Pillar platem. Diameter of Vanes (vertical).....m.
- Height of Cairn.....m. Diameter of Cairn.....m. Name Plate found/not found/placed.
- Length of Mastm. (approximate if not unpiled)
- A.....set in conc/rock has been placed/found, bearing.....° M from Mast/Plug/Pillar
 - A.....set in conc/rock has been placed/found, bearing.....° M from Mast/Plug/Pillar
 - A.....set in conc/rock has been placed/found, bearing.....° M from Mast/Plug/Pillar
 - A.....set in conc/rock has been placed/found, bearing.....° M from Mast/Plug/Pillar
8. Action required:.....

STANDPOINT:


Mark	Direction	Horiz. Distance	Height Difference	Mark	Direction	Horiz. Distance	Height Difference
			above standpt.				above standpt.
			below				below
			above standpt.				above standpt.
			below				below
Prepared by:..... Checked:.....

Noted on U.T.M. Card

Bt 2733-2 D. West, Government Printer

STATION BUNNAN WEST 1291

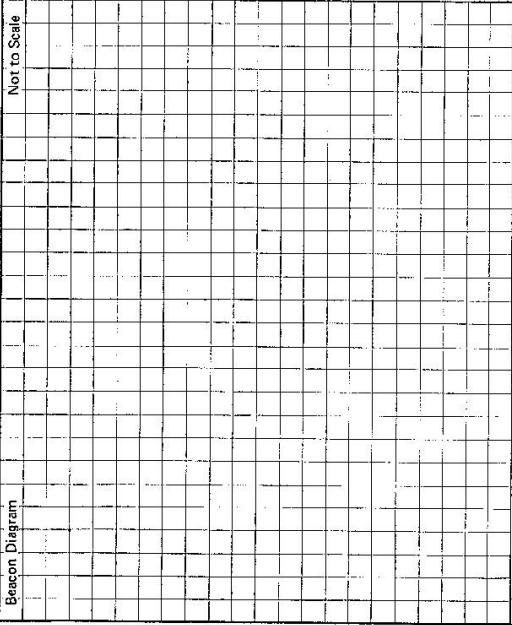Beacon Diagram	Not to Scale
	

Owner's Name:
Address:
Phone:
Current Occupant:
Address:
Phone:

ACCESS

Access Report of 18/7/1978 was found suitable/unsuitable.
For access see Bunnan 9033 - W-N
Drive to trig.
Rock cairn found. Remains of Mast & vanes found near cairn
Hills obstruct vision S to SE of trig. Light clearing required
Site not recommended for pillar construction

This section to be completed by officer constructing pillar.

Original station mark found/not found.

Description of mark:

Original beacon found/not found.

Description of beacon:

Height Top of Vanes to Top Mark m.

Height of mark m. above rock/conc m. below G.L.

Diameter of Vanes m. Height of Cairn m.

Original Beacon has/has not been destroyed by me.

Date	Record of Station

CENTRAL MAPPING AUTHORITY

GEODETIC SURVEY OF NS&W


GEODETIC STATION RECONNAISSANCE and MAINTENANCE REPORT

STATION: *BUNNAN WEST* No.: *1291*

MAP SHEET SCALE 1:250 000 *SINGLETON*

INSPECTED BY: *M. NYMAN* DATE: *31st Jan 80*

AUTHORITY: *C.M.A. NS&W 229* FIELD BOOK: *1837*

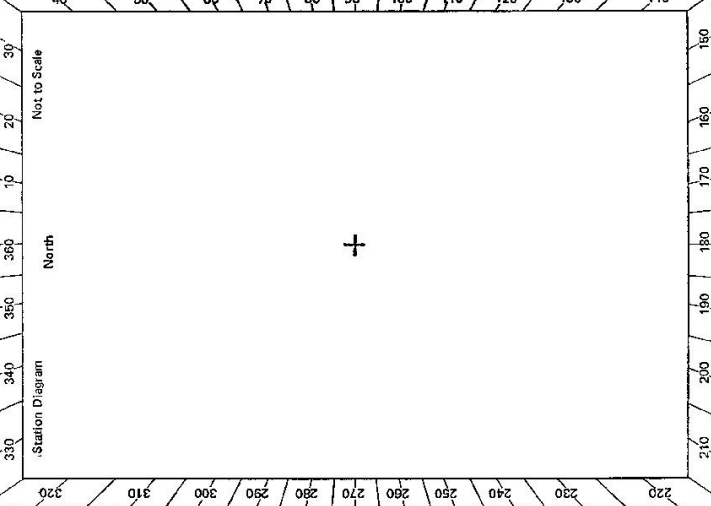

- Description:
- Cleared by Janes bearing $174^\circ \rightarrow 178^\circ$ $204' \rightarrow 177'$ from Trig. Mast. Note: Cross out word or words which do not apply
 - Mast & Vanes have been painted white & black respectively.
 - The station ~~has been~~ not unpiled/~~constructed~~ on *1st Jan 1980*, dimensions now being:
 - Description of mark.....should be explicit, e.g., S/Steel Pillar Plate, Steel plug, Brass plug, Bolt, G.I. Pipe
 - Height of mark.....m. ^{above}/_{below} rock/concrete; Mark is.....m. ^{above}/_{below} G.L.
 - Height of Top Vanes to Top Mark/Pillar plate.....m. ^{AD VANES} Diameter of Vanes (vertical).....m.
 - Height of Cairn.....m. Diameter of Cairn.....m. Name Plate ~~found~~/not found/~~placed~~.
 - A.....m. ~~Approx~~ *2.5* m. (approximate if not unpiled) *NO witness marks found*
 - A.....~~set in conc/rock~~ has been placed/found, bearing..... $^\circ$ M from Mast/Plug/Pillar
 - A.....~~set in conc/rock~~ has been placed/found, bearing..... $^\circ$ M from Mast/Plug/Pillar
 - A.....~~set in conc/rock~~ has been placed/found, bearing..... $^\circ$ M from Mast/Plug/Pillar
 - A.....~~set in conc/rock~~ has been placed/found, bearing..... $^\circ$ M from Mast/Plug/Pillar
 - Action required: *To be re-located*

STANDPOINT:							
Mark	Grid Direction	Horiz. Distance	Height Difference	Mark	Direction	Horiz. Distance	Height Difference
<i>Bunnan</i>		<i>to</i>	<i>Nov</i> above standpt.				above standpt.
<i>Cuan</i>	<i>52°</i>		<i>Nov</i> below				above standpt.
<i>Myall</i>	<i>78</i>		<i>Nov</i> above standpt.				below standpt.
<i>Arthill</i>	<i>98</i>		<i>Nov</i> below				above standpt.
<i>Gruidhi</i>	<i>177</i>		<i>Cairn</i> above standpt.				below standpt.
<i>Diamond</i>	<i>198</i>		<i>Hill</i> above standpt.				above standpt.
<i>Howard</i>	<i>107</i>		<i>Hill</i> below				below standpt.
<i>Howard</i>	<i>264</i>		<i>Nov</i> above standpt.				above standpt.

Prepared by: *P. Fanning* Checked: *C.M.C.* Noted on U.T.M. Card


STATION **BUNNAN WEST 1291**

Owner's Name: **Mr. Peter Bishop**
 Address: **Nilvera Py Ltd**
 Phone: **(065) 454333**
 Current Occupant:
 Address:
 Phone:

ACCESS

Access Report of: 31.1.198 was found suitable/unsuitable.

- 0-0 P.D. Merrivoe Travel "towards Scome
- 17-30 Cross "Halls Creek"
- 18-60 Cross Bridge (wooden)
- 21-2 Start of Bluman
- 23-94 Turn right through gate near water tank. Make way up hill in Easterly direction
- 26-24 Bunnan West C.P.

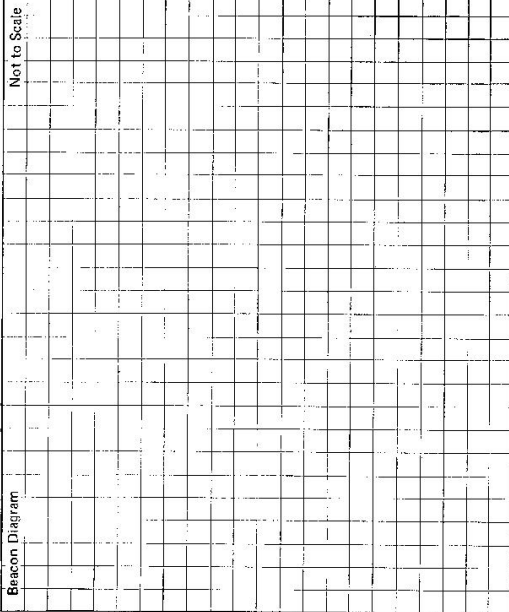

This section to be completed by officer constructing pillar.

Original station mark found/not found.

Description of mark:

Original beacon found/not found.

Description of beacon:

Height Top of Varies to Top Mark.....m.

Height of mark.....m. above G.L. below

Diameter of Varies.....m.

Original Beacon has/has not been destroyed by me.

Date	Record of Station
28/05/20	Owner requests to dig at present left on hill