

GEODETTIC SURVEY OF M.S.W.

CENTRAL MAPPING AUTHORITY

GEODETTIC STATION RECONNAISSANCE and MAINTENANCE REPORT

STATION: **BURDENDA G.S.** No.: **1295**

MAP SHEET
SCALE 1:250 000

MARDIMINE

INSPECTED BY: **R. COOK** DATE: **SEP 1978**

AUTHORITY: **C.M.A.** FIELD BOOK:

Description: *Note: Cross out word or words which do not apply*

1. Cleared by lanes bearing..... from Trig. Mast
2. Mast & Vanes have been painted white & black respectively.
3. The station/pillar ~~was not~~ not unpiled/constructed on.....19....., dimensions now being:
Description of mark. **C.P.**.....should be explicit, e.g., S/Steel Pillar Plate, Steel plug, Brass plug, Bolt, G.I. Pipe
Height of mark.....m. above rock/concrete; Mark is.....m. above G.L.
- Height of Top Vanes to Top Mark/Pillar plate.....m. Diameter of Vanes (vertical) **2.7.6**.....m.
- Height of Cairn.....m. Diameter of Cairn.....m. Name Plate found/not found/placed.
- Length of Mast.....m. (approximate if not unpiled)
4. A.....set in conc/rock has been placed/found, bearing.....° M from Mast/Plug/Pillar
5. A.....set in conc/rock has been placed/found, bearing.....° M from Mast/Plug/Pillar
6. A.....set in conc/rock has been placed/found, bearing.....° M from Mast/Plug/Pillar
7. A.....set in conc/rock has been placed/found, bearing.....° M from Mast/Plug/Pillar

8. Action required: **Examine clearing needed. Suitable for Pillar. Average condition.**


STANDPOINT:

Mark	Direction	Horiz. Distance	Height Difference	Mark	Direction	Horiz. Distance	Height Difference
			above standpt.				above standpt.
			below				below
			above standpt.				above standpt.
			below				below
Prepared by: **R. COOK**

Checked: *Noted on U.T.M. Card*

St 2738-1

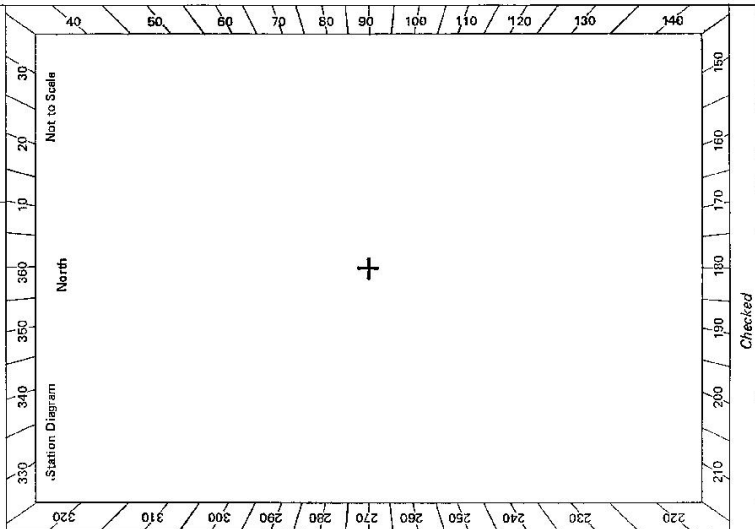

St 2783-2 D. West, Government Printer

STATION **BURDENDA G.S. 1295**


Owner's Name:
 Address:
 Phone:
 Current Occupant:
 Address:
 Phone:

ACCESS

Access Report of ^{Sept}...../...../1978 was found suitable/unsuitable.
Drive to (access) found on the Tottenham 1:50000 sheet

Not to Scale

Beacon Diagram

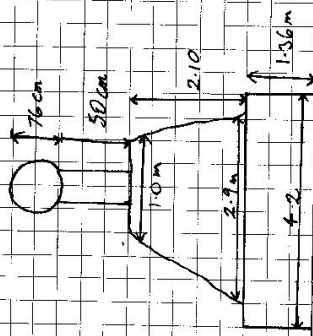

This section to be completed by officer constructing pillar.

Original station mark found/not found.

Description of mark:

Original beacon found/not found.

Description of beacon:

Height Top of Vanes to Top Markm.

Height of markm. above G.L.
 below rock/conc

Diameter of Vanesm.

Height of Cairnm.

Original Beacon has/has not been destroyed by me.

Date

Record of Station

SEPT 1978

STATION VISITED IN CONNECTION WITH FIELD COMPLETION