

GEODETTIC SURVEY OF N.S.W.

CENTRAL MAPPING AUTHORITY


GEODETTIC STATION RECONNAISSANCE and MAINTENANCE REPORT

STATION: **BURKE** No.: **1298**

MAP SHEET SCALE 1:250 000 **CANBERRA**

INSPECTED BY: **W. MILLER** DATE: **12-5-78**

AUTHORITY: **CMA** FIELD BOOK:

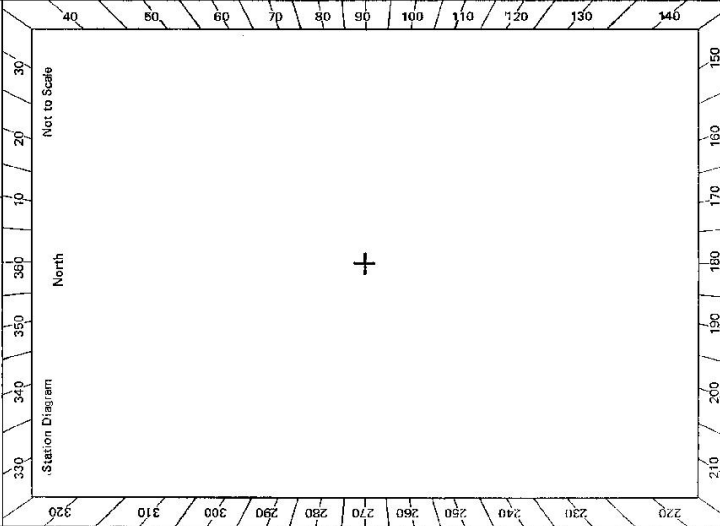

- Description:
- Note: Cross out word or words which do not apply*
- Cleared by lanes bearing..... *cleared to 5.0 m. from Trig. Mast*
 - Mast & Vanes have been painted white & black respectively.
 - The station/pillar was uplled/not uplled/constructed on..... 19....., dimensions now being: Description of mark..... should be explicit, e.g., S/Steel Pillar Plate, Steel plug, Brass plug, Bolt, G.I. Pipe Height of mark..... m. ^{above} rock/concrete; Mark is..... m. ^{above} G.L.
 - Height of Top Vanes to Top Mark/Pillar plate..... m. Diameter of Vanes (vertical)..... m.
 - Height of Cairn..... 2. m. Diameter of Cairn..... 1.5. m. Name Plate found/not found/placed.
 - Length of Mast..... 3. m. (approximate if not uplled)
 - A..... set in conc/rock has been placed/found, bearing..... °M from Mast/Plug/Pillar
 - A..... set in conc/rock has been placed/found, bearing..... °M from Mast/Plug/Pillar
 - A..... set in conc/rock has been placed/found, bearing..... °M from Mast/Plug/Pillar
 - A..... set in conc/rock has been placed/found, bearing..... °M from Mast/Plug/Pillar
 - Action required:.....

| STANDPOINT: | | | |
|-------------|-----------|-----------------|-------------------|
| Mark | Direction | Horiz. Distance | Height Difference |
| | | | above standpt. |
| | | | below standpt. |
| | | | above standpt. |
| | | | below standpt. |
Prepared by: *W. Miller*


Checked:

Noted on U.T.M. Card

Checked


Sr 2733-2 D. West, Government Printer

STATION **BURKE** 1298

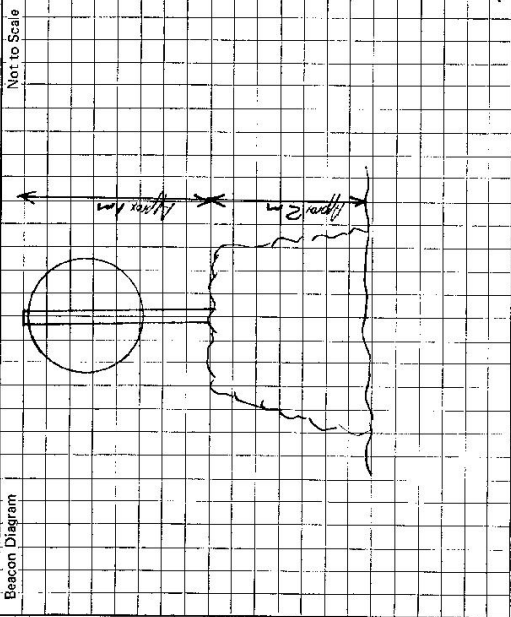

Owner's Name: **W. DEKALANDE**
 Address:
 Phone:
 Current Occupant:
 Address:
 Phone:

ACCESS
 Report of 12.1.5.1978 was found suitable/unsuitable.

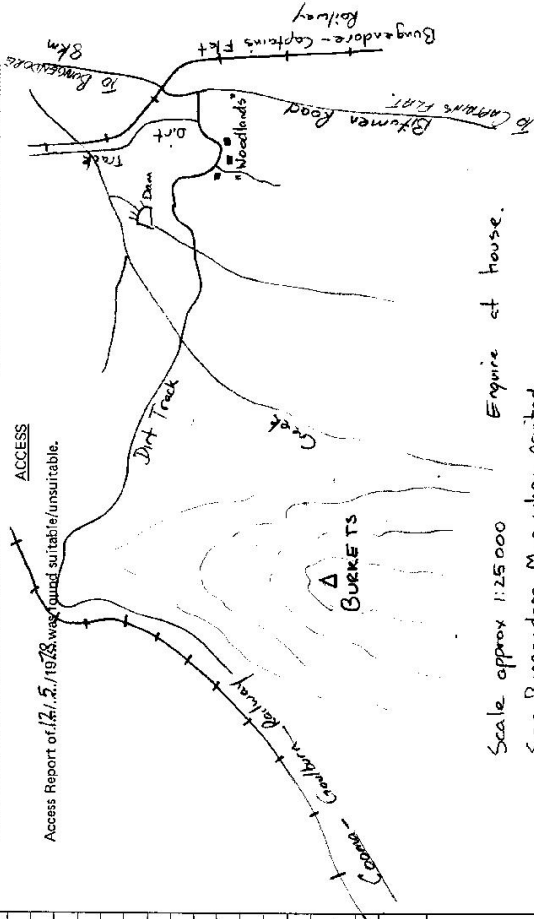

Scale approx 1:25 000
 See Bungandore Map when printed
 (1:25000)
 Enquire at house.

This section to be completed by officer constructing pillar.

Original station mark found/not found.

Description of mark:

Original beacon found/not found.

Description of beacon:

Height Top of Varies to Top Mark:m.

Height of mark:m. above G.L.
 below

Diameter of Variesm. Height of Cairnm.

Original Beacon has/has not been destroyed by me.

Date

11.5.78

Record of Station

Checked only to east