

CENTRAL MAPPING AUTHORITY


GEODETIC STATION RECONNAISSANCE and MAINTENANCE REPORT

STATION: SMA 0103 No.: 13

MAP SHEET SCALE 1:250 000 BEGA

INSPECTED BY: G. KEEP DATE: 16/4/80

AUTHORITY: FIELD BOOK:

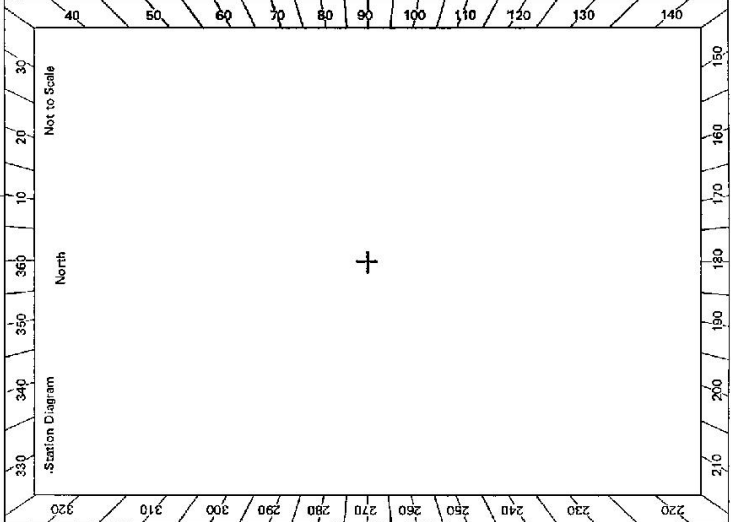

- Description:
- Cleared by lanes bearing..... Note: Cross out word or words which do not apply
 - Mast & Vanes have been painted white & black respectively.
 - The station/pillar was unpiled/not unpiled/constructed on.....19....., dimensions now being:
 - Description of mark..... should be explicit, e.g. S/Steel Pillar Plate, Steel plug, Brass plug, Bolt, G.I. Pipe
 - Height of mark.....m. above rock/concrete; Mark is.....m. above G.L.
 - Height of Top Vanes to Top Mark/Pillar plate.....m. Diameter of Vanes (vertical).....m.
 - Height of Cairn.....m. Diameter of Cairn.....m. Name Plate found/not found/placed.
 - Length of Mast.....m. (approximate if not unpiled)
 - A.....set in conc/rock has been placed/found, bearing.....°M from Mast/Plug/Pillar
 - A.....set in conc/rock has been placed/found, bearing.....°M from Mast/Plug/Pillar
 - A.....set in conc/rock has been placed/found, bearing.....°M from Mast/Plug/Pillar
 - A.....set in conc/rock has been placed/found, bearing.....°M from Mast/Plug/Pillar
 - Action required:.....

STANDPOINT:			
Mark	Direction	Horiz. Distance	Height Difference
			above standpt.
			below standpt.
			above standpt.
			below standpt.
Prepared by: G. Keep 24/7/80 Checked: Noted on U.T.M. Card

GS

<p>St 2733-2 D. West. Government Printer</p> <p>Beacon Diagram</p> <div style="border: 1px solid black; width: 100%; height: 150px; display: flex; align-items: center; justify-content: center;"> <p style="writing-mode: vertical-rl; transform: rotate(180deg); font-size: small;">Not to Scale</p> </div>	<table style="width: 100%; border-collapse: collapse;"> <tr> <td style="width: 50%; border-right: 1px solid black;"> <p style="text-align: center;">STATION SMA 0103 TS 13</p> <p>Owner's Name: Address: Phone:</p> <p style="text-align: center;"><u>ACCESS</u></p> <p>Access Report of...../19.....was found suitable/unsuitable. Station not seen due to high tree line in area traversed. Condition of station unknown. Suitable for geodetic station</p> </td> <td style="width: 50%;"> <p>Current Occupant: Address: Phone:</p> </td> </tr> </table>	<p style="text-align: center;">STATION SMA 0103 TS 13</p> <p>Owner's Name: Address: Phone:</p> <p style="text-align: center;"><u>ACCESS</u></p> <p>Access Report of...../19.....was found suitable/unsuitable. Station not seen due to high tree line in area traversed. Condition of station unknown. Suitable for geodetic station</p>	<p>Current Occupant: Address: Phone:</p>						
<p style="text-align: center;">STATION SMA 0103 TS 13</p> <p>Owner's Name: Address: Phone:</p> <p style="text-align: center;"><u>ACCESS</u></p> <p>Access Report of...../19.....was found suitable/unsuitable. Station not seen due to high tree line in area traversed. Condition of station unknown. Suitable for geodetic station</p>	<p>Current Occupant: Address: Phone:</p>								
<p>This section to be completed by officer constructing pillar.</p> <p>Original station mark found/not found.</p> <p>Description of mark:</p> <p>Original beacon found/not found.</p> <p>Description of beacon:</p> <p>Height Top of Vanes to Top Mark.....m. above rock/conc.....m. below G.L. Height of mark.....m. below</p> <p>Diameter of Vanesm. Height of Cairnm.</p> <p>Original Beacon has/has not been destroyed by me.</p>									
<table border="1" style="width: 100%; border-collapse: collapse;"> <tr> <td style="width: 50%; text-align: center;">Date</td> <td style="width: 50%; text-align: center;">Record of Station</td> </tr> <tr> <td style="height: 40px;"> </td> <td> </td> </tr> <tr> <td> </td> <td> </td> </tr> <tr> <td> </td> <td> </td> </tr> </table>		Date	Record of Station						
Date	Record of Station								

CENTRAL MAPPING AUTHORITY
 Department of Lands
 RECONNAISSANCE and MAINTENANCE REPORT

Trigonometrical Survey of N.S.W.


7.4-28

STATION SMA1018 (Pinnacle) TS 13
 Co: Salwayn Ph: Wallace

This Trig. Station has been:-
 Note: Cross out word or words which do not apply

1. Completely cleared to permit 360° vision to surrounding Triggs.
 2. Cleared by lanes bearing 53°M, 133°M, 154°M from Trig. Mast
 3. Trig. Mast & Vanes have been painted white & black respectively.
 4. The Trig. was unpiled/not unpiled, dimensions now being: Vertical Station Mark found / not found
- Description of mark: Brass Plug should be explicit, e.g. Steel plug, Brass plug, Bolt, G.I. Pipe
 Height of mark: m above, m below, m above, m below, G.I.
 Height of Top Vanes to Top Mark: 4.35 m Diameter of Vanes (vertical): 0.65 m.
 Height of Cairn: m Diameter of Cairn: m.

Map Sheet: Yarrango billy No: 8526
 Inspected by: N. D. Berge Date: 26th January 1977
 Authority: Central Mapping Field Book: 8526-11-N

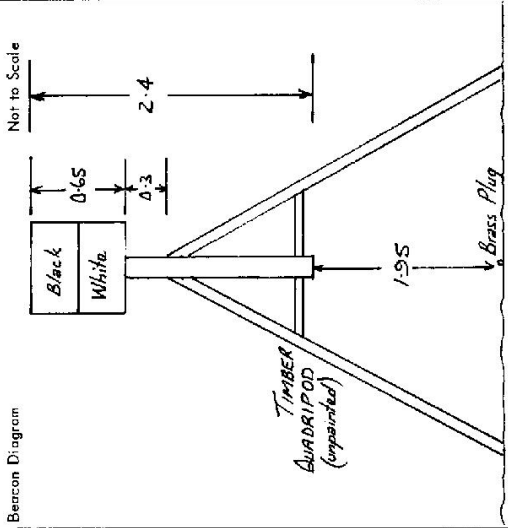

Date	Record of Station

5. A. set in conc/rock has been placed..... m. bearing.....°M from Trig. Mast
6. A. set in conc/soil has been placed..... m. bearing.....°M from Trig. Mast
7. A. set in conc/soil has been placed..... m. bearing.....°M from Trig. Mast
8. A. set in conc/rock has been placed..... m. bearing.....°M from Trig. Mast
9. Connection to..... m. bearing.....°M
10. Connection to..... m. bearing.....°M
11. Connection to..... m. bearing.....°M
12. Connection to..... m. bearing.....°M
13. Diff. Ht. is..... m. above below.....°M
14. Diff. Ht. is..... m. above below.....°M
15. Diff. Ht. is..... m. above below.....°M
16. Diff. Ht. is..... m. above below.....°M

Prepared by: N. D. Berge Checked: G. W. ... Noted on U.T.M. Card Checked

STATION SMA 1018 (PITCHGUT) TS 13


Owners Name.....
 Current Occupant.....

Address.....
 Address.....

Access Refer to Ravine 8526-11-N 1:25000
 26-1-1977

Not to Scale

Station Diagram

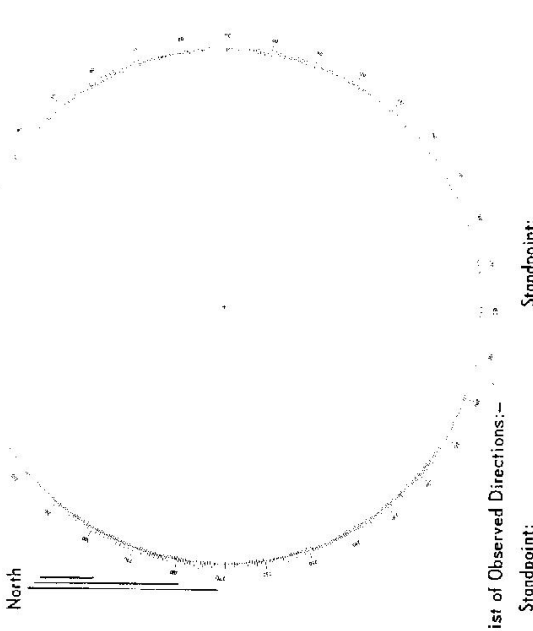

List of Observed Directions:-

Standpoint:		Standpoint:	
Station	Direction	Station	Direction

