

CENTRAL MAPPING AUTHORITY

GEODETIC SURVEY OF M.S.W.

GEODETIC STATION RECONNAISSANCE and MAINTENANCE REPORT

STATION: **BURRAGA** No: **1304**

MAP SHEET SCALE 1:250 000 **BATHURST**

INSPECTED BY: **K.J. HADJIOANNIS** DATE: **JULY 1979**

AUTHORITY: **C.M.A.** FIELD BOOK:

- Description:
1. Cleared by lanes bearing..... Note: *Cross out word or words which do not apply*..... from Trig. Mast
 2. Mast & Vanes have been painted white & black respectively.
 3. The station/pillar was unpiled/not unpiled/constructed on.....19....., dimensions now being: Description of mark.....should be explicit, e.g., S/Steel Pillar Plate, Steel plug, Brass plug, Bolt, G.I. Pipe Height of mark.....m. ^{above} _{below} rock/concrete; Mark is.....m. ^{above} _{below} G.L.
 - Height of Top Vanes to Top Mark/Pillar platem. Diameter of Vanes (vertical).....m.
 - Height of Cairn.....m. Diameter of Cairn.....m. Name Plate found/not found/placed.
 - Length of Mastm. (approximate if not unpiled)
 4. A.....set in conc/rock has been placed/found, bearing.....° M from Mast/Plug/Pillar
 5. A.....set in conc/rock has been placed/found, bearing.....° M from Mast/Plug/Pillar
 6. A.....set in conc/rock has been placed/found, bearing.....° M from Mast/Plug/Pillar
 7. A.....set in conc/rock has been placed/found, bearing.....° M from Mast/Plug/Pillar
 8. Action required:.....

STANDPOINT:


STANDPOINT:

Mark	Direction	Horiz. Distance	Height Difference	Mark	Direction	Horiz. Distance	Height Difference
			above standpt.				above standpt.
			below standpt.				below standpt.
			above standpt.				above standpt.
			below standpt.				below standpt.
Prepared by: *[Signature]*

Checked: *[Signature]*

Noted on U.T.M. Card

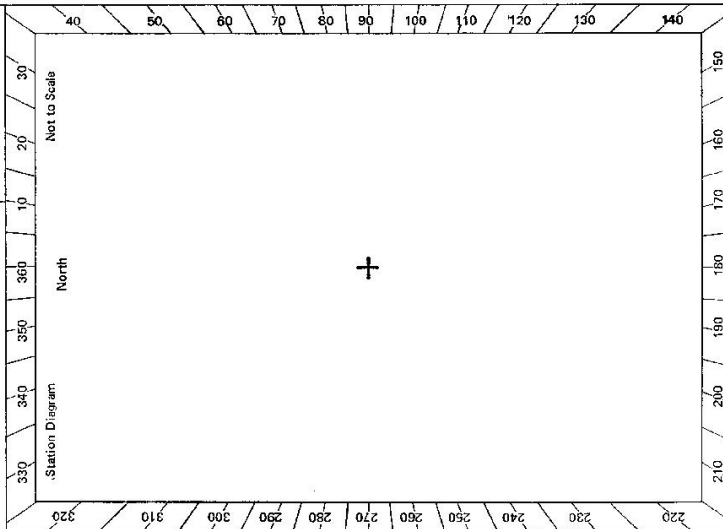

St 2735-2 D. West, Government Printer

<p>Beacon Diagram</p> <div style="border: 1px dashed gray; width: 100%; height: 100%; position: relative;"> Not to Scale </div>	<table border="1" style="width: 100%; border-collapse: collapse;"> <tr> <td style="width: 30%;"> <p>STATION <u>BURRAGA</u> <u>1304</u></p> </td> <td style="width: 70%;"> <p>Owner's Name:</p> <p>Address:</p> <p>Phone:</p> <p>Current Occupant:</p> <p>Address:</p> <p>Phone:</p> <p>ACCESS</p> <p>Access Report of <u>July</u> <u>1974</u> was found suitable/unsuitable.</p> <p>From Mount David proceed <u>7 km</u> south to T-Junction (000) and turn right towards Burraga.</p> <p>0.00 T-Junction</p> <p>3.0 Take left track through gate (signposted 'Ben ledi')</p> <p>3.5 Keep left</p> <p>4.7 Gate</p> <p>5.9 Gate Straight ahead</p> <p>7.3 Gate Straight ahead about 30m then take track to left up hill.</p> <p>7.5 Stop at top of hill. Trig 20m to left in pine trees</p> </td> </tr> </table>	<p>STATION <u>BURRAGA</u> <u>1304</u></p>	<p>Owner's Name:</p> <p>Address:</p> <p>Phone:</p> <p>Current Occupant:</p> <p>Address:</p> <p>Phone:</p> <p>ACCESS</p> <p>Access Report of <u>July</u> <u>1974</u> was found suitable/unsuitable.</p> <p>From Mount David proceed <u>7 km</u> south to T-Junction (000) and turn right towards Burraga.</p> <p>0.00 T-Junction</p> <p>3.0 Take left track through gate (signposted 'Ben ledi')</p> <p>3.5 Keep left</p> <p>4.7 Gate</p> <p>5.9 Gate Straight ahead</p> <p>7.3 Gate Straight ahead about 30m then take track to left up hill.</p> <p>7.5 Stop at top of hill. Trig 20m to left in pine trees</p>
<p>STATION <u>BURRAGA</u> <u>1304</u></p>	<p>Owner's Name:</p> <p>Address:</p> <p>Phone:</p> <p>Current Occupant:</p> <p>Address:</p> <p>Phone:</p> <p>ACCESS</p> <p>Access Report of <u>July</u> <u>1974</u> was found suitable/unsuitable.</p> <p>From Mount David proceed <u>7 km</u> south to T-Junction (000) and turn right towards Burraga.</p> <p>0.00 T-Junction</p> <p>3.0 Take left track through gate (signposted 'Ben ledi')</p> <p>3.5 Keep left</p> <p>4.7 Gate</p> <p>5.9 Gate Straight ahead</p> <p>7.3 Gate Straight ahead about 30m then take track to left up hill.</p> <p>7.5 Stop at top of hill. Trig 20m to left in pine trees</p>		
<p>This section to be completed by officer constructing pillar.</p> <p>Original station mark found/not found.</p> <p>Description of mark:</p> <p>Original beacon found/not found.</p> <p>Description of beacon:</p> <p>Height Top of Vanes to Top Mark.....m.</p> <p>Height of mark.....m. above G.L. below</p> <p>Diameter of Vanesm. Height of Cairnm.</p> <p>Original Beacon has/has not been destroyed by me.</p>			
<p>Date</p> <p><u>July 1974</u></p>	<p>Record of Station</p> <p><u>Cairn, vanes and vanees found. Trig surrounded by pine trees.</u></p>		