

CENTRAL MAPPING AUTHORITY

GEODETIC SURVEY OF N.S.W.


GEODETIC STATION RECONNAISSANCE and MAINTENANCE REPORT

STATION: **BURRAGORANG** No.: **1306**

MAP SHEET
SCALE 1:250 000 **WOLLONGONG**

INSPECTED BY: **W. MILLER, K#42224** DATE: **25-1-80**

AUTHORITY: **C.M.A.** FIELD BOOK:

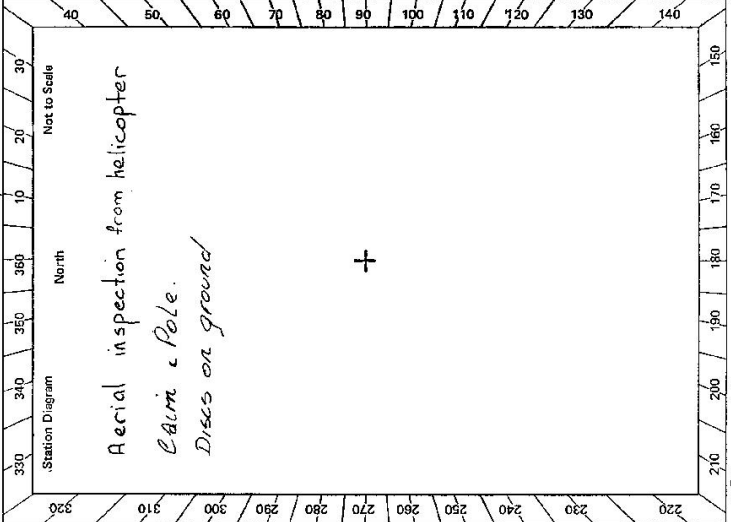

- Description:
- Cleared by Janes bearing..... *Note: Cross out word or words which do not apply*
by..... *by*..... from Trig, Mast
 - Mast & Vanes have been painted white & black respectively.
 - The station/pillar was unplaced/not unplaced/constructed on..... 19....., dimensions now being:
Description of mark..... should be explicit, e.g., S/Steel Pillar Plate, Steel plug, Brass plug, Bolt, G.I. Pipe
Height of mark.....^{above} rock/concrete; Mark is.....^{above}.....^{below} G.L.
Height of Top Vanes to Top Mark/Pillar plate.....m. Diameter of Vanes (vertical).....m.
Height of Cairn.....m. Diameter of Cairn.....m. Name Plate found/not found/placed.
Length of Mast.....m. (approximate if not unplaced)
 - A..... set in conc/rock has been placed/found, bearing.....°M from Mast/Plug/Pillar
 - A..... set in conc/rock has been placed/found, bearing.....°M from Mast/Plug/Pillar
 - A..... set in conc/rock has been placed/found, bearing.....°M from Mast/Plug/Pillar
 - A..... set in conc/rock has been placed/found, bearing.....°M from Mast/Plug/Pillar
 - Action required:.....


STANDPOINT:				STANDPOINT:			
Mark	Direction	Horiz. Distance	Height Difference	Mark	Direction	Horiz. Distance	Height Difference
			above standpt.				above standpt.
			below standpt.				below standpt.
			above standpt.				above standpt.
			below standpt.				below standpt.
Prepared by: *W. Miller* / 2-90 Checked: *W. Miller* / 2-90 Noted on U.T.M. Card Checked

SI 2720-2 D West Government Printer

Beacon Diagram

Not to Scale

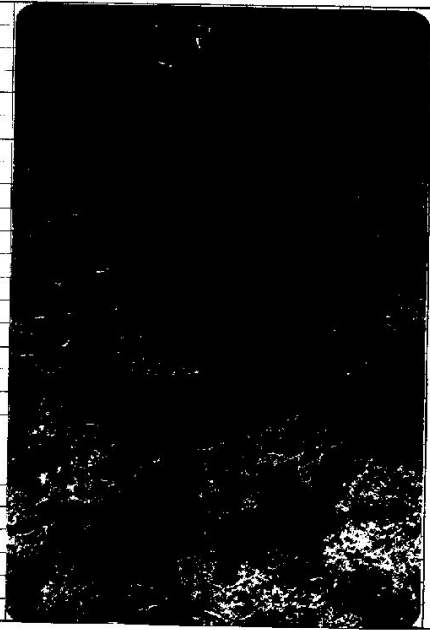

STATION **BURRAGORANG** **1306**

Owner's Name: **M. W. S. D. B.**
 Address: **Managamba Dam**
 Phone:
 Current Occupant:
 Address:
 Phone:
ACCESS
 Access Report of **25/1/1980** was found suitable/unsuitable.

*See Burragorang 1:31680 map
 possible access from Lake Burragorang*

This section to be completed by officer constructing pillar.

Original station mark found/not found.

Description of mark:

Original beacon found/not found.

Description of beacon:

Height Top of Vanes to Top Markm.

Height of markm. above below rock/conem. above below G.L.

Diameter of Vanesm. Height of Cairnm.

Original Beacon has/has not been destroyed by me.

Date	Record of Station
25.1.80	Aerial inspection by helicopter