

CENTRAL MAPPING AUTHORITY

GEODETIC STATION RECONNAISSANCE and MAINTENANCE REPORT

STATION: **BURRAWANG** No.: **1809**

MAP SHEET SCALE 1:250 000
INSPECTED BY: **Wollongong**


DATE: **17-1-79**

AUTHORITY: **CMA** FIELD BOOK: **1723**

- Description:
- Cleared by lanes bearing..... **See →**..... from Trig. Mast
 - Mast & Vanes have been painted white & black respectively. **MW5438**
 - The station/pillar was unpiled/~~not supported~~/constructed on..... 19....., dimensions now being:
Description of mark: **S/S. P. in conc.** should be explicit. e.g., S/Steel Pillar Plate, Steel plug, Brass plug, Bolt, G.I. Pipe
Height of mark.....m. above rock/concrete; Mark is.....m. above G.L.
Height of Top Vanes to Top Mark/~~Pillar plate~~..... **4.87**.....m. Diameter of Vanes (vertical)..... **0.92**.....m.
Height of Cairn.....m. Diameter of Cairn.....m. Name Plate found/not found/placed.
Length of Mast.....m. (approximate if not unpiled)
 - A.....set in conc/rock has been placed/found, bearing.....° M from Mast/Plug/Pillar
 - A.....set in conc/rock has been placed/found, bearing.....° M from Mast/Plug/Pillar
 - A.....set in conc/rock has been placed/found, bearing.....° M from Mast/Plug/Pillar
 - A.....set in conc/rock has been placed/found, bearing.....° M from Mast/Plug/Pillar
 - Action required:..... **ROBERTSON**
Steel Topo

STANDPOINT:			
Mark	Direction	Horiz. Distance	Height Difference
			above standpt.
			below standpt.
			above standpt.
			below standpt.
Prepared by: *[Signature]* 25-1 Checked: *[Signature]*
Noted on U.T.M. Card

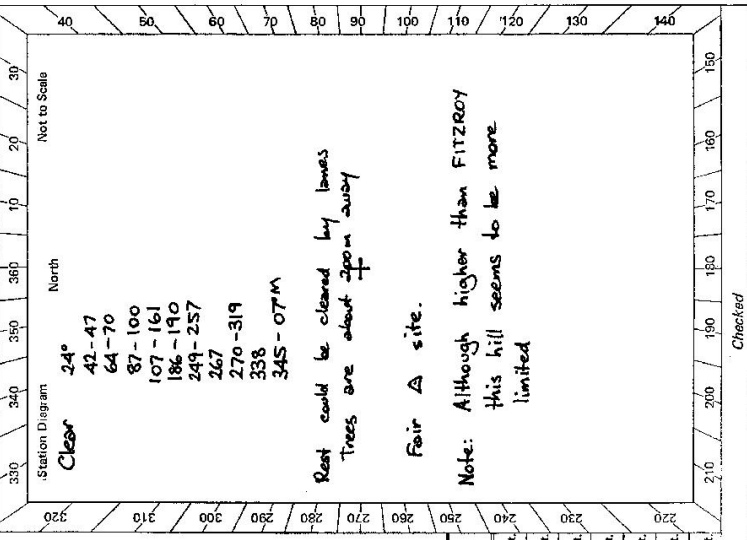

Not to Scale

Checked

STATION **BURRAWANG** 1309

Owner's Name:
 Address:
 Phone:
 Current Occupant:
 Address:
 Phone:

ACCESS


Access Report of 17.1.19. *M* was found suitable/unsuitable.

AWD

km
 0.0 BURRAWANG P.O. Take **WADDLE ST** west
 0.1 Cross sealed road & go down gravel road
 0.8 Turn R through iron gate just after power line
 1.0 Through right hand (iron) gate of follow fence
 1.3 Turn L through gate of fence enr.
 1.5 BURRAWANG Δ

Not to Scale

Beacon Diagram

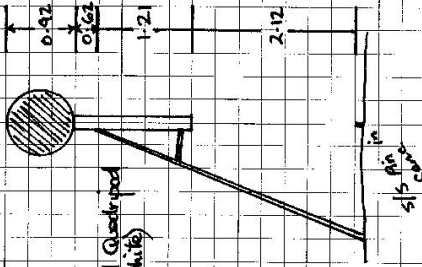

This section to be completed by officer constructing pillar.

Original station mark found/not found.

Description of mark:

Original beacon found/not found.

Description of beacon:

Height Top of Vanes to Top Markm.

Height of markm. above rock/cont. below G.L.

Diameter of Vanesm.

Height of Cairnm.

Original Beacon has/has not been destroyed by me.

Date

Record of Station