

GEODETIC SURVEY OF N.S.W.

CENTRAL MAPPING AUTHORITY


GEODETIC STATION RECONNAISSANCE and MAINTENANCE REPORT

STATION: **BYRON** No.: **1334**

MAP SHEET SCALE 1:250 000 **CANBERRA**

INSPECTED BY: **W MILLER** DATE: **10-5-78**

AUTHORITY: **CMA** FIELD BOOK:

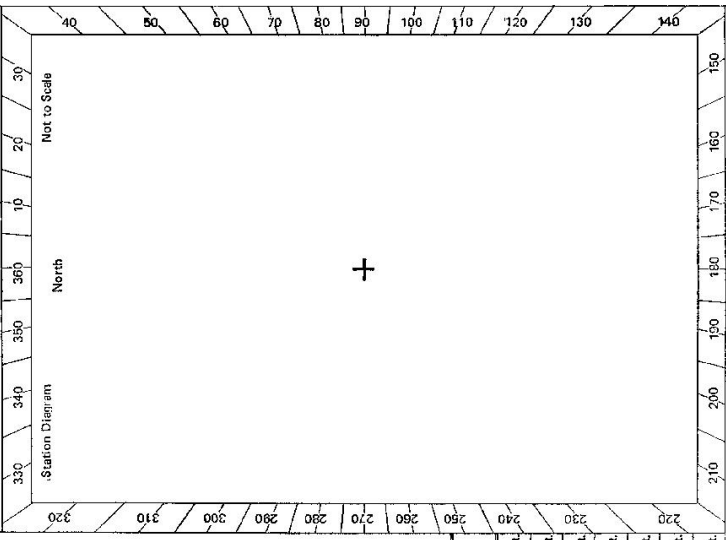

- Description:
1. Cleared by Janes bearing. *Note: Cross out word or words which do not apply*  
 Not Cleared. from Trig. Mast
  2. Mast & Vanes have been painted white & black respectively.
  3. The station/pillar was unpiled/hot unpiled/constructed on 19....., dimensions now being:  
 Description of mark.....should be explicit, e.g, S/Steel Pillar Plate, Steel plug, Brass plug, Bolt, G.I. Pipe  
 Height of mark.....m. above below rock/concrete; Mark is.....m. above G.L.  
 Height of Top Vanes to Top Mark/Pillar plate.....m. Diameter of Vanes (vertical).....m.  
 Height of Cairn.....m. Diameter of Cairn.....m. Name Plate-found/not-found/placed.  
 Length of Mast.....m. (approximate if not unplied)
  4. A.....set in conc/rock has been placed/found, bearing.....°M from Mast/Plug/Pillar
  5. A.....set in conc/rock has been placed/found, bearing.....°M from Mast/Plug/Pillar
  6. A.....set in conc/rock has been placed/found, bearing.....°M from Mast/Plug/Pillar
  7. A.....set in conc/rock has been placed/found, bearing.....°M from Mast/Plug/Pillar
  8. Action required:.....

STANDPOINT:							
Mark	Direction	Horiz. Distance	Height Difference	Mark	Direction	Horiz. Distance	Height Difference
			above standpt				above standpt
			below standpt				below standpt
			above standpt				above standpt
			below standpt				below standpt
			above standpt				above standpt
			below standpt				below standpt
			above standpt				above standpt
			below standpt				below standpt



Prepared by: *W.Miller* Checked: *W.Miller* Noted on U.T.M. Card

STATION **BYRON** 1334

Owner's Name: .....  
 Address: *The Gibb* .....  
 Phone: *Bungah-Captain's Flat Road* .....

Current Occupant: .....  
 Address: .....  
 Phone: .....

ACCESS  
 Access Report of 15/5/1978 was found suitable/unsuitable.

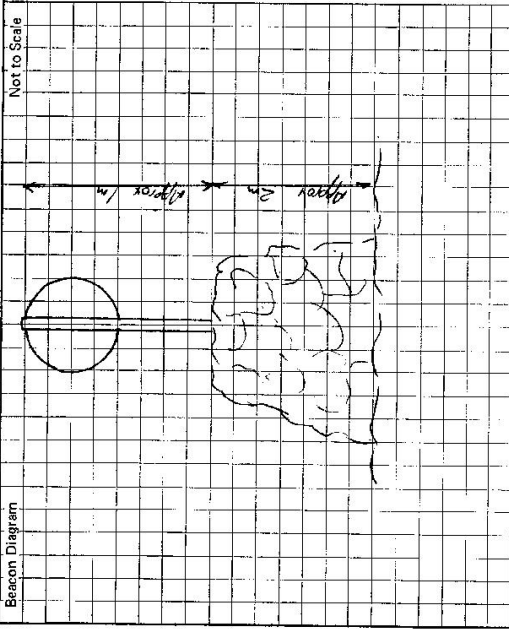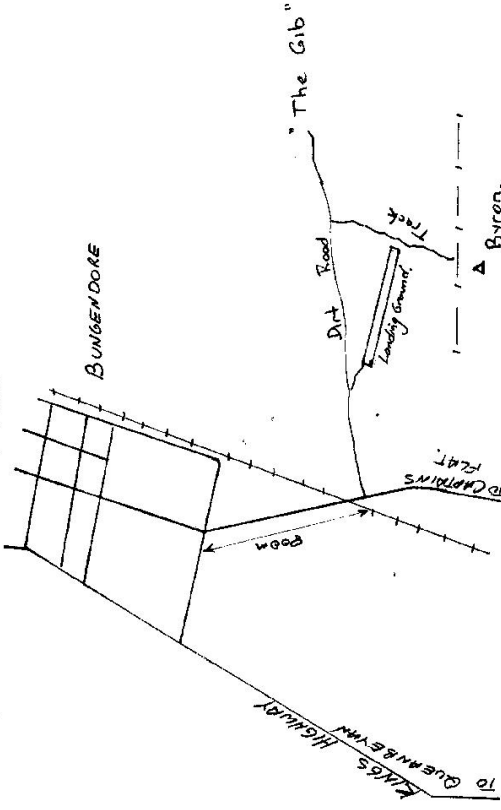

This section to be completed by officer constructing pillar.

Original station mark found/not found.  
 Description of mark: .....  
 Original beacon found/not found.  
 Description of beacon: .....  
 Height Top of Vanes to Top Mark .....m.  
 Height of mark .....m. above G.L. below G.L.  
 Diameter of Vanes .....m. Height of Cairn .....m.  
 Original Beacon has/has not been destroyed by me.

Date: *10.5.78*  
 Record of Station: *Visited Changing Marked*