
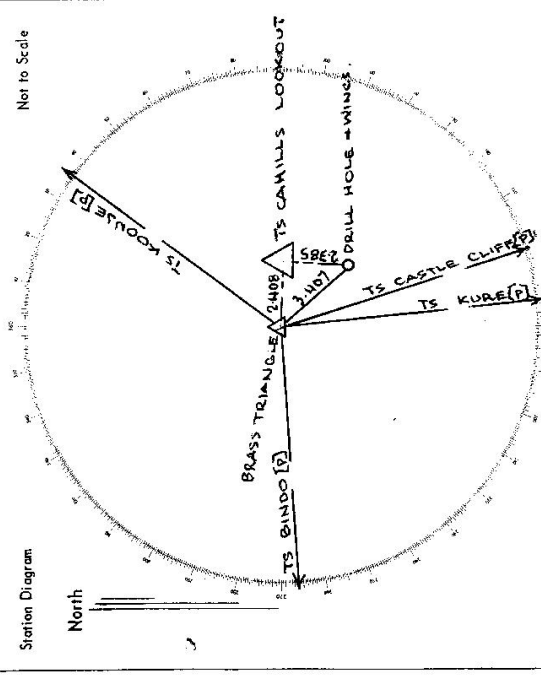


1347 STATION TS CAHILLS LOOKOUT

Owners Name.....
 Current Occupant.....
 Address.....
 Address.....

Access 16-12-1981
 0.0 km Katoomba Railway Station
 Proceed west along Great Western Highway
 1.35 km Turn left off Highway onto Valley Road and follow this road
 2.0 km Turn right into Cliff Drive, which winds around past -
 3.5 km Packmans Plateau.
 3.9 km Parking area for Cahills Lookout.
 Proceed on foot through small scenic area and thence down concrete footpath to Lookout & Monument.

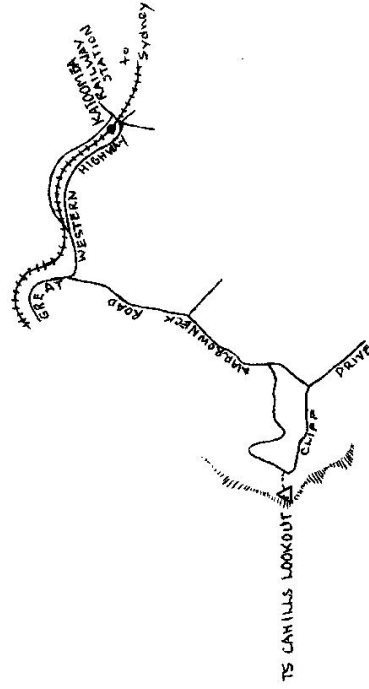

List of Observed Directions:-

Standpoint: BRASS TRIANGLE		Standpoint: DRILL HOLE	
Station	Direction	Station	Direction
KOONJE (P) TS	36° 00' 00"	BRASS TRIANGLE	318° 41' 49"
CASTLE CLIFF (P) TS	162° 03' 02"	CAMILLS LOOKOUT TS	3° 41' 03"
KURE (P) TS	174° 15' 48"		
BINDO (P) TS	266° 21' 45"		
CAHILLS LOOKOUT TS	94° 17' 35"		
DRILL HOLE	138° 42' 49"		
Station	Direction	Station	Direction