


7-4-99

STATION CALABAR T.S. 1351  
 Co: CUMBERLAND Ph: NKRTU COLAHU  
 Map Sheet: SYDNEY No: S130-N1  
 Inspected by: K.J.HADDON Date: 28TH JULY 1976  
 Authority: C.M.A. Field Book:

Beacon Diagram  
Not to Scale

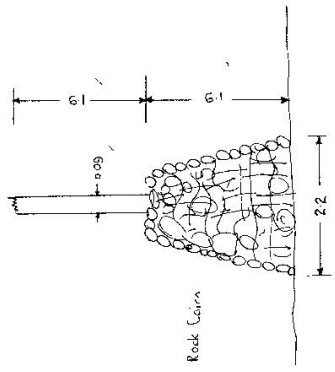

This Trig. Station has been: Note: Cross out word or words which do not apply

1. Completely cleared to permit 360° vision to surrounding Trigs.
  2. Cleared by lanes bearing from Trig-Mast
  3. Trig-Mast & Vanes have been painted white & black respectively.
  4. The Trig. was unpiled/not unpiled, dimensions now being: Original 2.2m 0.09m
- Description of mark: should be explicit, e.g. Steel plug, Brass plug, Bolt, G.I. Pipe
- Height of mark:                      m <sup>above</sup>                      m <sup>below</sup>                      rock/concrete G.L.
- Height of Top Vanes to Top Mark:                      m. Diameter of Vanes (vertical):                      m.
- Height of Cairn:                      m. Diameter of Cairn:                      m.
- Length of Mast:                      m. (approximate if not unpiled)
5. A                      set in conc/rock has been placed:                      m. bearing:                      %M from Trig. Mast
  6. A                      set in conc/soil has been placed:                      m. bearing:                      %M from Trig. Mast
  7. A                      set in conc/soil has been placed:                      m. bearing:                      %M from Trig. Mast
  8. A                      set in conc/rock has been placed:                      m. bearing:                      %M from Trig. Mast

9. Connection:                      to                      m. bearing:                      %M
10. Connection:                      to                      m. bearing:                      %M
11. Connection:                      to                      m. bearing:                      %M
12. Connection:                      to                      m. bearing:                      %M
13. Diff. Ht.                      is                      m. <sup>above</sup>                      <sup>below</sup>
14. Diff. Ht.                      is                      m. <sup>above</sup>                      <sup>below</sup>
15. Diff. Ht.                      is                      m. <sup>above</sup>                      <sup>below</sup>
16. Diff. Ht.                      is                      m. <sup>above</sup>                      <sup>below</sup>

Prepared by:                      Checked:                      Noted on U.T.M. Card

Date	Record of Station

**Non-Geodetic**

STATION CALABASH T.S. ) 1351

Owners Name..... Current Occupant.....

Address..... Address.....

Access: 28-7-1976  
kms

0.00 Intersection of Berouwa Arcadia Road and Chilcott Road 3.6 km from Berouwa Ferry  
or 4.7 kms from Arcadia Public School. Proceed North along Chilcott Road.

0.25 Keep Left

0.40 End Bitumen. Berkeley Public School on left.


0.60 House on left ('BALPINE') Make PR visit to this house.

0.80 Turn right to go around end of fence.

1.00 Turn right back onto track.

1.60 Track appears to end. Leave vehicle.

Follow ridge and saddles to north. Approx 30 minute easy walk to T.S.

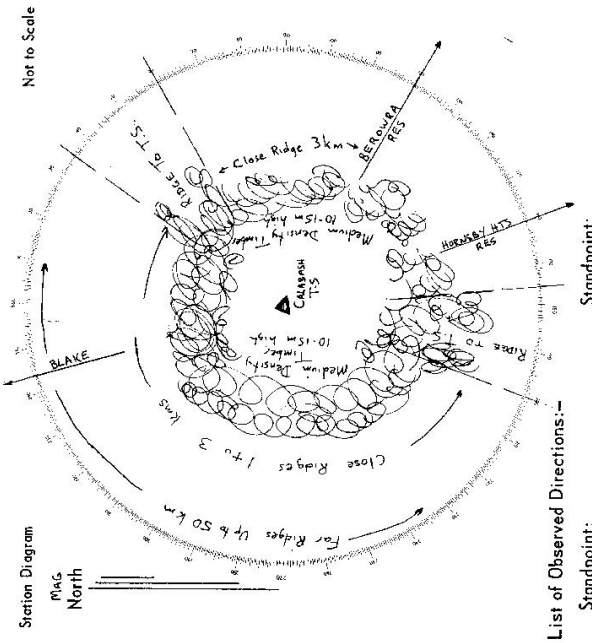

List of Observed Directions:-

Standpoint:	
Station	Direction

Standpoint:	
Station	Direction