

CENTRAL MAPPING AUTHORITY

GEODETIC SURVEY OF N.S.W.

GEODETIC STATION RECONNAISSANCE and MAINTENANCE REPORT

STATION: CALEDONIA. No.: 1353

MAP SHEET SCALE 1:250 000

INSPECTED BY: G Jones DATE: 23/6/81

AUTHORITY: CMA. FIELD BOOK: 19/5

Description: Note: Cross out word or words which do not apply
 Cleared by lanes bearing. See diagram from Trig. Mast

1. Mast & Vanes have been painted white & black respectively.
 2. The station/pillar was unpiled/not unpiled/constructed on..... 19....., dimensions now being:

Description of mark..... should be explicit, e.g., S/Steel Pillar Plate, Steel plug, Brass plug, Bolt, G.I. Pipe
 Height of mark.....m. above rock/concrete; Mark is.....m. above G.L.

Height of Top Vanes to Top Mark/Pillar plate.....m. Diameter of Vanes (vertical).....m.

Height of Cairn.....m. Diameter of Cairn.....m. Name Plate found/not found/placed.

Length of Mast.....m. (approximate if not unpiled)

4. A.....set in conc/rock has been placed/found, bearing.....°M from Mast/Plug/Pillar

5. A.....set in conc/rock has been placed/found, bearing.....°M from Mast/Plug/Pillar


6. A.....set in conc/rock has been placed/found, bearing.....°M from Mast/Plug/Pillar

7. A.....set in conc/rock has been placed/found, bearing.....°M from Mast/Plug/Pillar

8. Action required: ~~4~~ No. Oct/07


STANDPOINT:				STANDPOINT:			
Mark	Direction	Horiz. Distance	Height Difference	Mark	Direction	Horiz. Distance	Height Difference
			above standpt.				above standpt.
			below				below
			above standpt.				above standpt.
			below				below
Prepared by: G.J. 20/7/81 Checked: G.J. 21/7/81 Noted on U.T.M. Card

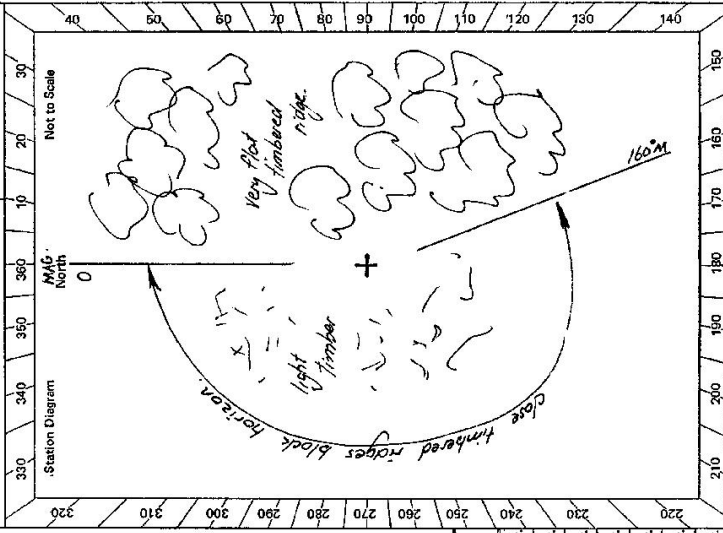

Checked

SI 2733-2 D. West. Government Printer

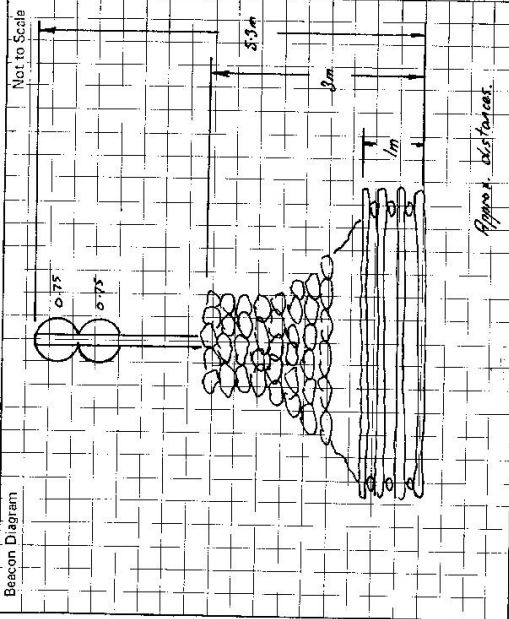

This section to be completed by officer constructing pillar.

Original station mark found/not found.

Description of mark:

Original beacon found/not found.

Description of Beacon:

Height Top of Vanes to Top Mark.....m.

Height of mark.....m. above G.L.
below

Diameter of Vanes.....m. Height of Cairn.....m.

Original Beacon has/has not been destroyed by me.

STATION

CALEDONIA TS 1353

Owner's Name: *TR 4419*

Address: *Base Oc 51/5*

Phone: *0460*

Per Occ. *Access through*

Current Occupant: *DR LARRY BERWICK*

Address: *KYARA*

Phone: *See access*

ACCESS

Access Report of *27.6/1981* was found suitable/unsuitable.

0-0 *Railway crossing in DUBBO, on Newell Hwy towards GILGONRA*

0-15 *Travel north.*

0-35 *Turn right, sign 'Gilgandra'*

7-5 *Turn left, sign 'Gilgandra'*

7-5 *at BROCKLEHURST. Turn right, sign 'Murrumbidgee'*

10-8 *Follow sealed road to the left.*

21-3 *Straight ahead, sign 'Murrumbidgee'*

22-6 *Pass sealed road on right and gravel road on left.*

23-06 *Cross railway.*

25-3 *Turn left over railway into 'KYARA' property.*

25-6 *At homestead (Mr Berwick) Turn right through sheds and then*

26-05 *along the left side of the dam.*

26-50 *Turn right through iron gate, drive along edge of timber.*

26-75 *Turn left through gateway.*

27-05 *Turn right up through timber.*

(Two all weather access)

Date

Record of Station

Station is not suitable for mapping or geodetic surveys