

CENTRAL MAPPING AUTHORITY  
GEODETTIC SURVEY OF N.S.W.

GEODETTIC STATION RECONNAISSANCE and MAINTENANCE REPORT

Description:  
1. Cleared by lanes bearing.....  
Note: Cross out word or words which do not apply

- Mast & Vanes have been painted white & black respectively.  
Note: Cross out word or words which do not apply from Trig. Mast
- The station/pillar was unpiled/not unpiled/constructed on.....19....., dimensions now being:  
Description of mark.....should be explicit, e.g., S/Steel Pillar Plate, Steel plug, Brass plug, Bolt, G.I. Pipe  
Height of mark.....m. <sup>above</sup> rock/concrete; Mark is.....m. <sup>above</sup> G.L.  
Height of Top Vanes to Top Mark/Pillar plate.....m. Diameter of Vanes (vertical).....m.  
Height of Cairn.....m. Diameter of Cairn.....m. Name Plate found/not found/placed.  
Length of Mast.....m. (approximate if not unpiled)
- A.....set in conc/rock has been placed/found, bearing.....°M from Mast/Plug/Pillar
- A.....set in conc/rock has been placed/found, bearing.....°M from Mast/Plug/Pillar
- A.....set in conc/rock has been placed/found, bearing.....°M from Mast/Plug/Pillar
- A.....set in conc/rock has been placed/found, bearing.....°M from Mast/Plug/Pillar
- Action required:.....

STANDPOINT:

Mark	Direction	Horiz. Distance	Height Difference	Mark	Direction	Horiz. Distance	Height Difference
			above standpt.				above standpt.
			below standpt.				below standpt.
			above standpt.				above standpt.
			below standpt.				below standpt.
Prepared by: *[Signature]* 24/1/19

Checked: *[Signature]*

Noted on U.T.M. Card

Checked

STATION: CALYMEA G.S. No.: 1359  
 MAP SHEET: NOLLANGONG  
 SCALE 1:250 000  
 INSPECTED BY: M.L. Mason DATE: 11/1/19  
 AUTHORITY: C.M.A. FIELD BOOK: 1720

Station Diagram  
 North  
 330 340 350 360 370 380 390 400  
 270 280 290 300 310 320  
 140 130 120 110 100 90 80 70 60 50 40  
 Not to Scale  
 Trig. set in good condition  
 No other marks set  
 All 1 day to sucker existing  
 lanes Van Hill.  
 Surrounding hills appear to  
 be about the same height  
 or higher than this hill.  
 +


STATION **CALYMEA G.S. TS 1359**

Owner's Name: .....  
 Address: .....  
 Phone: .....  
 Current Occupant: .....  
 Address: .....  
 Phone: .....

**ACCESS**

Access Report of 11/11/1979 was found suitable/unsuitable.

- Dir.**
- 0.00 On Princes Hwy South of Moura at Sea Venom Plane take road to HMAS Albatross B Burnier 14.
  - 0.80 Turn right sign Dangera Dam Yalwal
  - 4.70 Pass road to tip on right
  - 6.15 Pass road on right
  - 7.65 Pass road on left.
  - 8.95 Turn left down track across creek and onto ridge head to western edge of ridge
  - 9.80 Park truck. Head west across small creek than along rocky ridge to trig. 25mins with light load

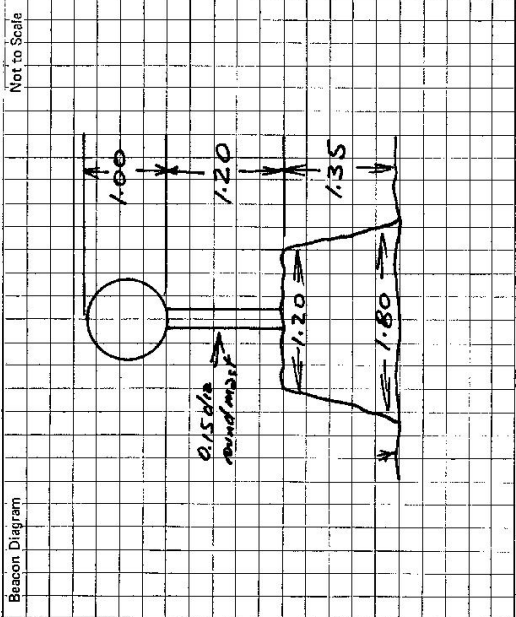

Not to Scale

This section to be completed by officer constructing pillar.

Original station mark found/not found.

Description of mark: .....

Original beacon found/not found.

Description of beacon: .....

Height Top of Vanes to Top Mark: .....m.

Height of mark: .....m above G.L.  
 .....m below

Diameter of Vanes .....m.

Original Beacon has/has not been destroyed by me.

Date	Record of Station