

CENTRAL MAPPING AUTHORITY

GEODETIC SURVEY OF N.S.W.
 GEODETIC STATION RECONNAISSANCE and MAINTENANCE REPORT

STATION: **CAMPBELL GS** TS No.: **1369**
 MAP SHEET SCALE 1:250 000 **CANBERRA**
 INSPECTED BY: **W MILLER** DATE: **10-1-79**
 AUTHORITY: **CMA** FIELD BOOK:


Description:

1. Cleared by lanes bearing.....*Note: Cross out word or words which do not apply*
 Not observed..... from Trig. Mast
2. Mast & Vanes have been painted white & black respectively.
3. The station/pillar was ~~unpiled~~/~~not unpiled~~ on.....**19.7.9**..... dimensions now being:
 Description of mark..... should be explicit, e.g., S/Steel Pillar Plate, Steel plug, Brass plug, Bolt, G.I. Pipe
 Height of mark.....^{above} rock/concrete; Mark is.....^{above} m; ^{below} G.L.
 Height of Top Vanes to Top Mark/Pillar plate m. Diameter of Vanes (vertical)..... m.
 Height of Cairn..... m. Diameter of Cairn..... m. Name Plate found/not found/placed.
 Length of Mast..... **4.4**..... m. (approximate if not unpiled)
4. A..... set in conc/rock has been placed/found, bearing.....°M from Mast/Plug/Pillar
5. A..... set in conc/rock has been placed/found, bearing.....°M from Mast/Plug/Pillar
6. A..... set in conc/rock has been placed/found, bearing.....°M from Mast/Plug/Pillar
7. A..... set in conc/rock has been placed/found, bearing.....°M from Mast/Plug/Pillar
8. Action required:.....

STANDPOINT:							
Mark	Direction	Horiz. Distance	Height Difference	Mark	Direction	Horiz. Distance	Height Difference
			above standpt.				above standpt.
			below				below
			above standpt.				above standpt.
			below				below
Prepared by: *W Miller* 24.1.79 Checked: *W Miller* Noted on U.T.M. Card

St 2733-2 D. West, Government Printer

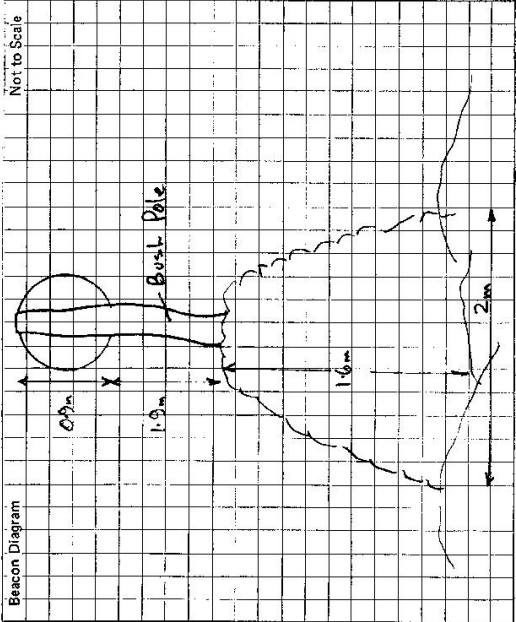

This section to be completed by officer constructing pillar.

Original station mark found/not found.

Description of mark:

Original beacon found/not found.

Description of beacon:

Height Top of Vanes to Top Mark.....m.

Height of mark.....m. above G.L. below

Diameter of Vanes.....m.

Original Beacon has/has not been destroyed by mts.

STATION **CAMPBELL TS 1369**


Owner's Name: **SANDLISON "Burra Brae"**
 Address: **SANDY ROAD**
 Phone: **Vic. Queensland**

Current Occupant:
 Address:
 Phone:

ACCESS

Access Report of 10/1/1979 was found suitable/unsuitable.

At about 20km from Queensland
 turn right up candy road.
 Follow bitumen road to end and
 turn right. Follow dirt road to
 end of "Burra Brae". Leave
 vehicle and walk.

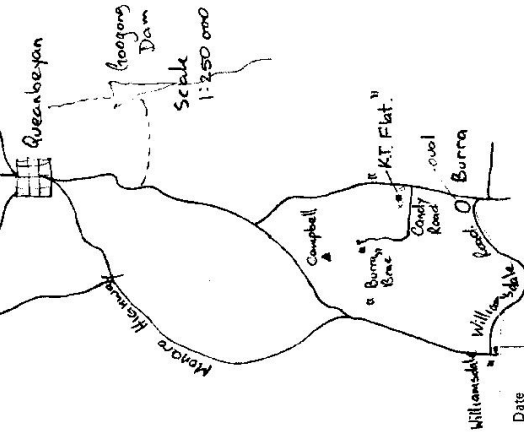

Record of Station

Date

10.1.79 *Visited*