

GEODETIC SURVEY OF NSW

GEODETIC STATION RECONNAISSANCE and MAINTENANCE REPORT


STATION: CANAL No. 1376

- 1. Checked by: *G. Bush*
- 2. *Steel Plate Vane*
- 3. The station *plate* was *replaced* not *unplugged* constructed on *concrete* 19 *years* dimensions now being *100mm x 100mm*

INSPECTED BY: *G. Bush* DATE: *11-2-80*
 AUTHORITY: *A.S.O.* FIELD BOOK:

N.B. SSM 51411 placed 26/11/87 & TM9 unspiled & bubble

Description of object: *Steel Plate Vane* should be explicit, e.g., *Steel Pillar Plate, Steel plug, Brass plug, Bolt, G.I. Pipe*
 Material: *concrete*
 Diameter of Vane (vertical): *100* m.
 Diameter of Cairn: *100* m.
 Name Plate band: *SSM 51411*
 set in *concrete*/rock has been placed/~~found~~; bearing: *101.5*° M from East/~~Plug~~/~~Pillar~~
 set in *concrete*/rock has been placed/~~found~~; bearing: *101.5*° M from East/~~Plug~~/~~Pillar~~
 set in *concrete*/rock has been placed/~~found~~; bearing: *101.5*° M from East/~~Plug~~/~~Pillar~~
 set in *concrete*/rock has been placed/~~found~~; bearing: *101.5*° M from East/~~Plug~~/~~Pillar~~

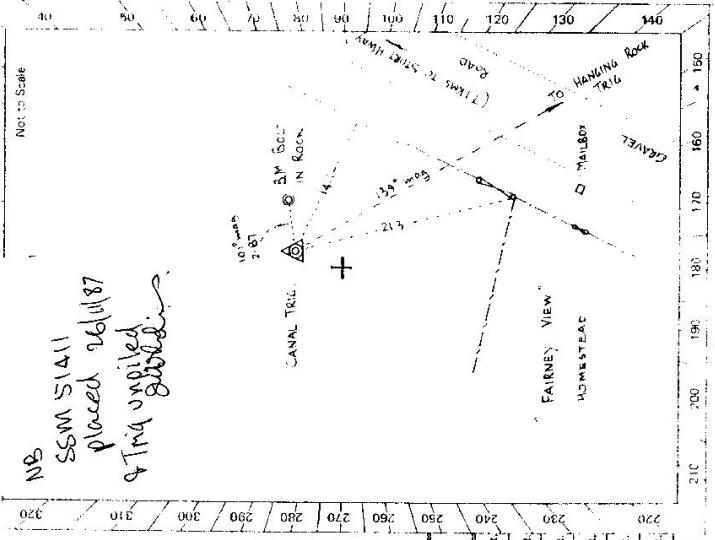


STANDPOINT:

Mark	Direction	Horiz. Distance	Height Difference	Director	Horiz. Distance	Height Difference
			above standpt.			above standpt.
			below			below
			above standpt.			above standpt.
			below			below
Prepared by: *U.M. Carr*
 Checked:

c

STATION CANAL TS 1376	Current Occupant: Address: Phone: ACCESS Access Report of 11.12.1980 was found suitable/unsuitable.
Owner's Name: Address: Phone:	
Date 11.2.80	Report in Good Condition Pole & Cairn in Good Condition Scale 1:250 000

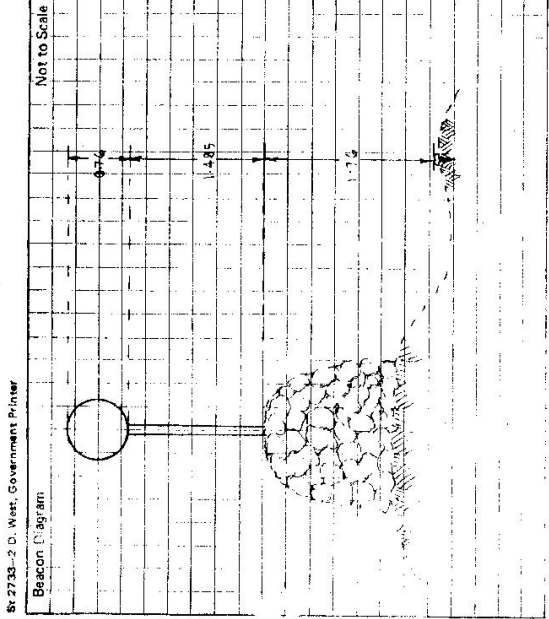

This diagram is to be used by office, subtracting pillar
 Original height of marker found
 Description of mark
 Original beacon found ~~not found~~
 Description of beacon: **POLE & CAIRN (GOOD CONDITION)**
 Height Top of Vents to Top Mark: m.
 Height of mark above/below G.L.: m.
 Diameter of Vents: m.
 Height of Cairn: m.
 Remarks: Beacon has not been destroyed by me.

CENTRAL MAPPING AUTHORITY

GEODETTIC STATION RECONNAISSANCE and MAINTENANCE REPORT

Description:

1. Cleared by lanes bearing Clean, S.S.M. 300 \rightarrow 1.80 from Trig, Mast

2. Mast & Vanes have been painted white & black respectively.

3. The station/pillar was unplaced/~~not unplaced~~/~~constructed~~ on 26/11/87, dimensions now being:

Description of mark Brass Plug should be explicit, e.g., S/Steel Pillar Plate, Steel plug, Brass plug, Bolt, G.I. Pipe

Height of mark 0.07 m. above ~~stone~~ rock/~~concrete~~ 1.80 m. above G.L. of granite boulders on top of group

Height of Top Vanes to Top Mark/Pillar plate 2.85 m. Diameter of Vanes (vertical) 0.77 m.

Height of Cairn 1.2 m. Diameter of Cairn 2 m. Name Plate found/not found/placed.

Length of Mast 2.85 m. (approximate if not unplaced) Box of mast rests on plug

4. A SSM 51411 set in ~~stone~~ rock has been placed/~~found~~, bearing 329° M from Mast/Plug/Pillar

5. A Bolt set in ~~stone~~ rock has been placed/~~found~~, bearing 102° M from Mast/Plug/Pillar

6. A SSM 51411 set in ~~stone~~ rock has been placed/~~found~~, bearing 329° M from Mast/Plug/Pillar Bolt

7. A Bolt set in conc./rock has been placed/~~found~~, bearing 102° M from Mast/Plug/Pillar


8. Action required:

STANDPOINT: Trig Plug STATIONPOINT: SSM 51411

Mark	Direction	Horiz. Distance	Height Difference	Mark	Direction	Horiz. Distance	Height Difference
<u>Hanging Bolt GS</u>	<u>0 00 00</u>		<u>above</u> <u>standpt.</u>	<u>Hanging Bolt GS</u>	<u>0 00 00</u>		<u>above</u> <u>standpt.</u>
<u>SSM 51411</u>	<u>219° 01' 30"</u>	<u>4.89</u>	<u>above</u> <u>standpt.</u>	<u>Cairn Plug</u>	<u>38° 15' 15"</u>	<u>4.89</u>	<u>above</u> <u>standpt.</u>
<u>Pemungdama</u>	<u>310° 42' 08"</u>		<u>above</u> <u>standpt.</u>	<u>Light house Hill</u>	<u>87° 36' 44"</u>		<u>above</u> <u>standpt.</u>
<u>Bolt</u>	<u>322° 56' 05"</u>	<u>2.53</u>	<u>above</u> <u>standpt.</u>	<u>Bolt</u>	<u>12° 01' 14"</u>	<u>6.83</u>	<u>above</u> <u>standpt.</u>
			<u>above</u> <u>standpt.</u>				<u>above</u> <u>standpt.</u>
			<u>above</u> <u>standpt.</u>				<u>above</u> <u>standpt.</u>
Prepared by: I.W. Rehmis Checked: 16/11/87

Noted on U.T.M. Card

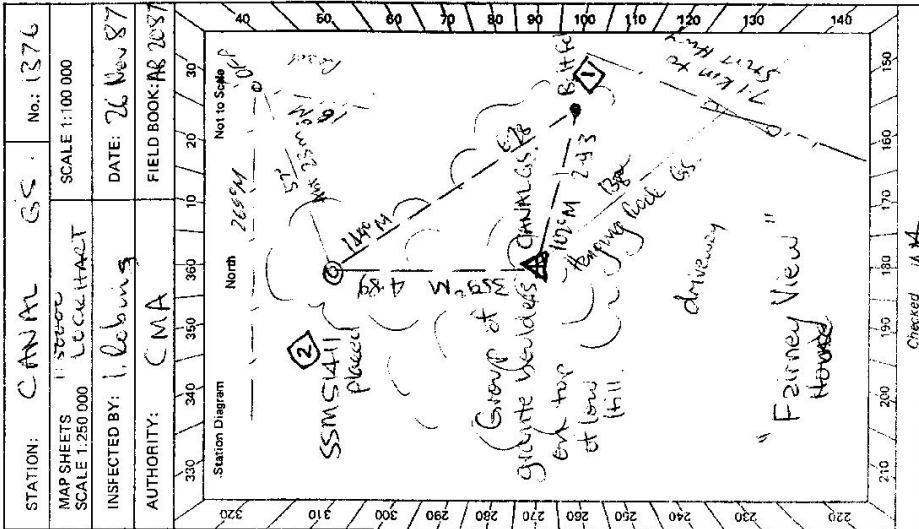

Checked: 16/11/87

STATION: CANAL GS No.: 1376

MAP SHEETS 1:250,000 SCALE 1:100,000

INSPECTED BY: I. Robinson DATE: 26 Nov 87


AUTHORITY: CMA FIELD BOOK: AB 2087

STATION CANAL G.S TS 1376

Owner's Name
 Address
 Phone:
 Current Occupant:
 Address:
 Phone:

ACCESS

Access Report of 26/11/1987 was found suitable/unavailable.
 Km 80
 Collingullie Cross Roads Motel; head western
 Sturt Highway
 Pass Coolamen Road on right
 Pass Camerons Road to Bettyrinden on left
 Turn left: Signposted Bulgary Siding
 Cross Bulgary Bridge (SP)
 20.1 Cross railway: end of bitumen
 21.6 Pass road to right
 22.9 Canal G.S on RT5 near "Fairney View" house.

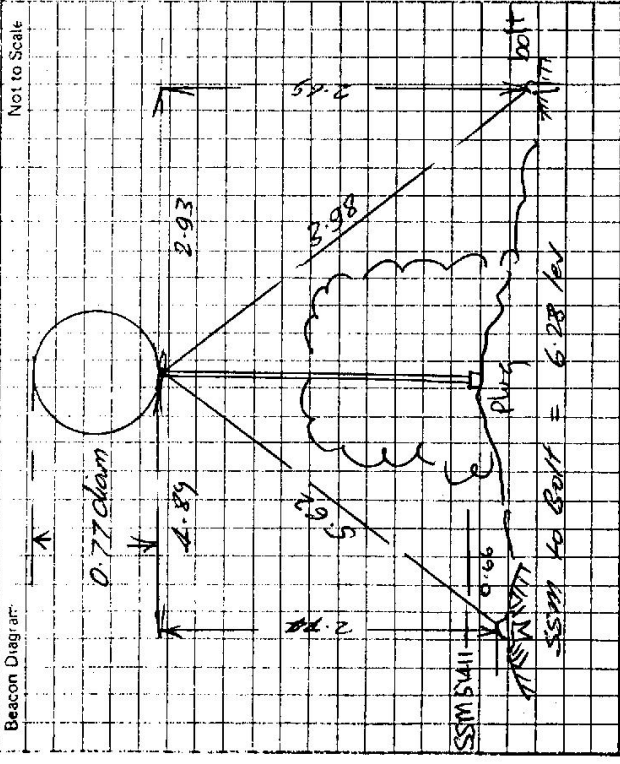

This section to be completed by officer constructing pillar.

Original station mark found/not found.

Description of mark:

Original beacon found/not found.

Description of beacon:

Height Top of Vanes to Top Mark.....m.

Height of mark.....m. above G.L. below

Diameter of Vanesm.

Original Beacon has/not been destroyed by me.

Record of Station

Date	Record of Station
1889	Copper plug in live rock placed
11/2/1980	Bolt in rock placed by A.S.O
26/11/1987	SSM 5411 placed by CMAA connected to plug & bolt. Cairn repaired.