

74-98

CENTRAL MAPPING AUTHORITY
 Department of Lands
 Trigonometrical Survey of N.S.W.
 RECONNAISSANCE and MAINTENANCE REPORT

This Trig. Station has been: *timbered blocking cleared to permit 360° vision to surrounding Trigs.*
 Note: Cross out word or words which do not apply

1. Completely ~~cleared to permit~~ *timbered blocking cleared to permit* 360° vision to surrounding Trigs.
2. Cleared by lances bearing *from Trig. Mast*
3. Trig. Mast & Vanes have been ~~pointed white & black respectively~~
4. The Trig. was ~~emptied~~ *emptied* not unpiled, dimensions now being: *not found*


Description of mark *should be explicit, e.g. Steel plug, Brass plug, Bolt, G.I. Pipe*
 Height of mark *rock/concrete* m above below G.L.
 Height of Top Vanes to Top Mark m. Diameter of Vanes (vertical) *0.920* m.
 Height of Cairn *1.10 top* m. Diameter of Cairn *1.60 base* m.
 Length of Mast *3.506* m. (approximate if not unpiled)

5. A. ~~set in conc/rock has been placed~~ m. bearing °M from Trig. Mast
6. A. ~~set in conc/soil has been placed~~ m. bearing °M from Trig. Mast
7. A. ~~set in conc/soil has been placed~~ m. bearing °M from Trig. Mast
8. A. ~~set in conc/rock has been placed~~ m. bearing °M from Trig. Mast
9. Connection ~~to~~ m. bearing °M
10. Connection ~~to~~ m. bearing °M
11. Connection ~~to~~ m. bearing °M
12. Connection ~~to~~ m. bearing °M
13. Diff. Ht. ~~is~~ m. above below
14. Diff. Ht. ~~is~~ m. above below
15. Diff. Ht. ~~is~~ m. above below
16. Diff. Ht. ~~is~~ m. above below

Prepared by: *M.L. Morrison* Checked: *M.L. Morrison* Noted on U.T.M. Card

STATION *CANGAI TS 1382*
 Co: *DRAKE* Ph: *CANGAI*
 Map Sheet: *Newton Boyd* No: *9338*
 Inspected by: *M.L. Morrison* Date: *25 July 1977*
 Authority: *Field Book: 1580*

Beacon Diagram Not to Scale

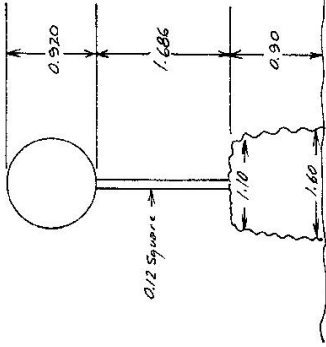

Date: *25 July 1977*
 Record of Station
Trig. is in Fair Condition Needs Pointing & New Mast. All Day Clearing Required Approx 5.5m to 11m (16m to 37m. Horizon is cleared by a Large Mast. Ridge Running from N to S. away)

Checked

