

CENTRAL MAPPING AUTHORITY

GEODETIC SURVEY OF N.S.W.


GEODETIC STATION RECONNAISSANCE and MAINTENANCE REPORT

STATION: CAPEEN No: 1388

MAP SHEET SCALE 1:250 000 WARWICK (CAPEEN 1:25,000)

INSPECTED BY: A. Sivertsen DATE: 4-7-80

AUTHORITY: CMA FIELD BOOK: 1848

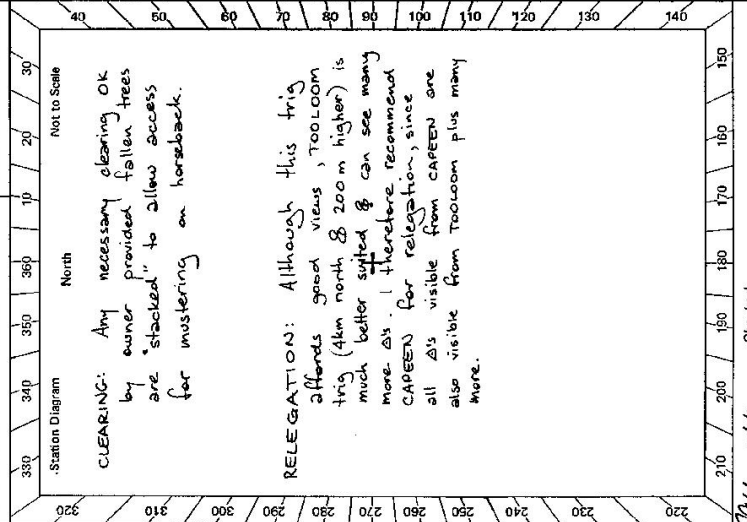

- Description: *Note: Cross out word or words which do not apply*
- Cleared by lanes bearing 360° ~~South~~ ~~East~~ ~~West~~ ~~North~~ from Trig. Mast
 - Mast & Vanes have been painted white & black respectively.
 - The station/pillar was unpiled/not unpiled/constructed on 19 dimensions now being: Description of mark should be explicit, e.g., S/Steel Pillar Plate, Steel plug, Brass plug, Bolt, G.I. Pipe
- Height of mark m. ^{above} rock/concrete; Mark is m. ^{above} G.L.
- Height of Top Vanes to Top Mark/Pillar plate m. Diameter of Vanes (vertical) m.
- Height of Cairn m. Diameter of Cairn m. Name Plate found/not found/placed.
- Length of Mast m. (approximate if not unpiled)
- A set in conc/rock has been placed/found, bearing M from Mast/Plug/Pillar
 - A set in conc/rock has been placed/found, bearing M from Mast/Plug/Pillar
 - A set in conc/rock has been placed/found, bearing M from Mast/Plug/Pillar
 - A set in conc/rock has been placed/found, bearing M from Mast/Plug/Pillar
8. Action required:

Mark Required	Direction	Horiz. Distance	Height Difference	Mark	Direction	Horiz. Distance	Height Difference
NONE			above standpt.	OTHERE'S			above standpt.
			below standpt.	All on Summary Card			below standpt.
			above standpt.	will be OK with Clearing			above standpt.
			below standpt.				below standpt.
			above standpt.				above standpt.
			below standpt.				below standpt.
			above standpt.				above standpt.
			below standpt.				below standpt.
			above standpt.				above standpt.
			below standpt.				below standpt.

STANDPOINT:

Prepared by: A. Sivertsen 17-7-80 Checked: *[Signature]* Noted on U.T.M. Card

