

GEODETIC SURVEY OF M.S.W.

CENTRAL MAPPING AUTHORITY

GEODETIC STATION RECONNAISSANCE and MAINTENANCE REPORT

Description:

Note: Cross out word or words which do not apply

1. Cleared by lanes bearing: from Trig. Mast
2. Mast & Vanes have been painted white & black respectively.
3. The station/pillar was unpiled/not unpiled/constructed on 19....., dimensions now being: should be explicit, e.g., S/Steel Pillar Plate, Steel plug, Brass plug, Bolt, G.I. Pipe
- Description of mark:
 Height of mark:m. ^{above} _{below} rock/concrete; Mark ism. ^{above} _{below} G.L.
 Height of Top Vanes to Top Mark/Pillar platem. Diameter of Vanes (vertical)m.
 Height of Cairn:m. Diameter of Cairnm. Name Plate found/not found/placed.
 Length of Mastm. (approximate if not unpiled)
4. A set in conc/rock has been placed/found, bearing° M from Mast/Plug/Pillar
5. A set in conc/rock has been placed/found, bearing° M from Mast/Plug/Pillar
6. A set in conc/rock has been placed/found, bearing° M from Mast/Plug/Pillar
7. A set in conc/rock has been placed/found, bearing° M from Mast/Plug/Pillar
8. Action required:

STANDPOINT:

Mark	Direction	Horiz. Distance	Height Difference	Mark	Direction	Horiz. Distance	Height Difference
			above standpt.				above standpt.
			below standpt.				below standpt.
			above standpt.				above standpt.
			below standpt.				below standpt.
			above standpt.				above standpt.
			below standpt.				below standpt.
			above standpt.				above standpt.
			below standpt.				below standpt.

Prepared by: 


Checked: 

Noted on U.T.M. Card

Checked

STATION: CAPPED Hill S.S.	No.: 1391
MAP SHEET SCALE 1:250 000	
INSPECTED BY: A.L. Macrae DATE: 18-1-79	
AUTHORITY: CMA FIELD BOOK: 1720	

Station Diagram

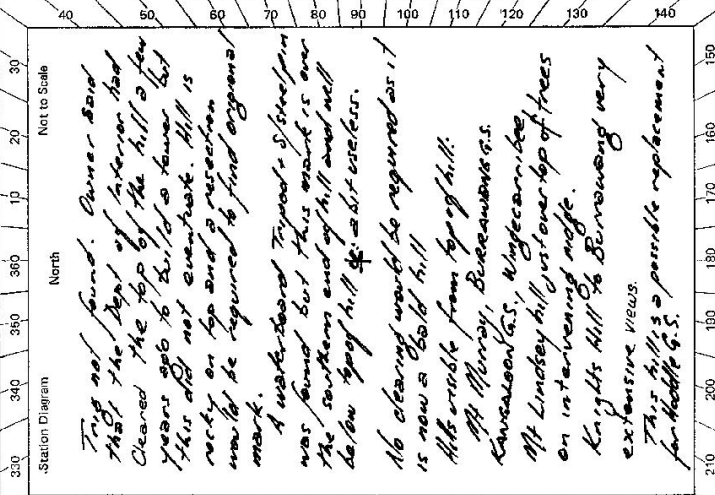

Not to Scale

