

CENTRAL MAPPING AUTHORITY


GEODETIC SURVEY OF N.S.W.
 GEODETIC STATION RECONNAISSANCE and MAINTENANCE REPORT

STATION: CARGELLIGO No.: 1404

MAP SHEET SCALE 1:250 000 CARGELLIGO

INSPECTED BY: G. C. HANNA DATE: 23/5/79

AUTHORITY: C. M. A. FIELD BOOK:

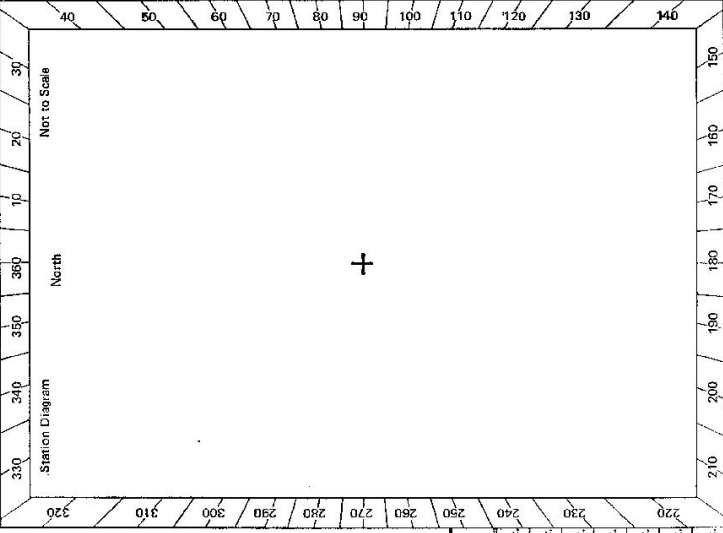

- Description:
- Note: Cross out word or words which do not apply
- Cleared by lances bearing..... from Trig. Mast
 - Mast & Vanes have been painted white & black respectively.
 - The station/pillar was unpiled/not unpiled/constructed on..... 19..... dimensions now being:
 Description of mark..... should be explicit, e.g., S/Steel Pillar Plate, Steel plug, Brass plug, Bolt, G.I. Pipe
 Height of mark..... m. ^{above} _{below} rock/concrete; Mark is..... m. ^{above} _{below} G. L.
 - Height of Top Vanes to Top Mark/Pillar plate..... m. Diameter of Vanes (vertical)..... m.
 - Height of Cairn..... m. Diameter of Cairn..... m. Name Plate found/not found/placed.
 - Length of Mast..... m. (approximate if not unpiled)
 - A..... set in conc/rock has been placed/found, bearing..... ° M from Mast/Plug/Pillar
 - A..... set in conc/rock has been placed/found, bearing..... ° M from Mast/Plug/Pillar
 - A..... set in conc/rock has been placed/found, bearing..... ° M from Mast/Plug/Pillar
 - A..... set in conc/rock has been placed/found, bearing..... ° M from Mast/Plug/Pillar
 - Action required:.....

STANDPOINT:

Mark	Direction	Horiz. Distance	Height Difference	Mark	Direction	Horiz. Distance	Height Difference
			above standpt.				above standpt.
			below				below
			above standpt.				above standpt.
			below				below
Prepared by: *G. Hanna 24/5/79* Checked: *[Signature]*
 Noted on U.T.M. Card

CENTRAL MAPPING AUTHORITY

GEODETIC SURVEY OF N.S.W.

GEODETIC STATION RECONNAISSANCE and MAINTENANCE REPORT

Description:

Note: Cross out word or words which do not apply

1. Cleared by Vanes bearing..... from Trig. Mast
2. Mast & Vanes have been painted white & black respectively.
3. The station/pillar was unpiled/not unpiled/constructed on..... 19..... dimensions now being:
Description of mark..... should be explicit, e.g., S/Steel Pillar Plate, Steel plug, Brass plug, Bolt, G.I. Pipe
Height of mark..... m. above rock/concrete; Mark is..... m. above G.L.
Height of Top Vanes to Top Mark/Pillar plate m. Diameter of Vanes (vertical)..... m.
Height of Cairn..... m. Diameter of Cairn..... m. Name Plate found/not found/placed.
Length of Mast m. (approximate if not unpiled)
4. A..... set in conc./rock has been placed/found, bearing..... ° M from Mast/Plug/Pillar
5. A..... set in conc./rock has been placed/found, bearing..... ° M from Mast/Plug/Pillar
6. A..... set in conc./rock has been placed/found, bearing..... ° M from Mast/Plug/Pillar
7. A..... set in conc./rock has been placed/found, bearing..... ° M from Mast/Plug/Pillar
8. Action required: Station not suitable for use in 1:4000 Mapping


STANDPOINT:

Mark	Direction	Horiz. Distance	Height Difference	Mark	Direction	Horiz. Distance	Height Difference
			above standpt.				above standpt.
			below				below
			above standpt.				above standpt.
			below				below
Prepared by: K. Hudson 31-3-82

Checked: *[Signature]* Noted on U.T.M. Card

SI 2735-1

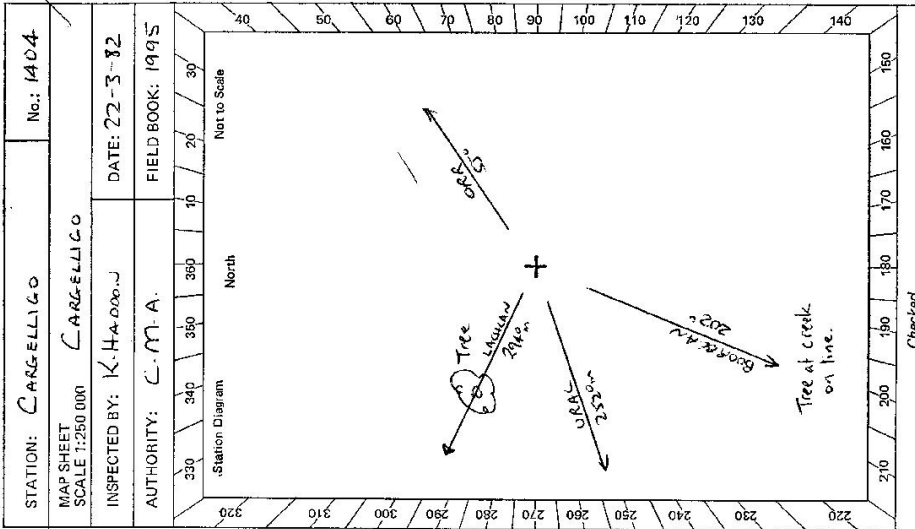

Checked

STATION: CARPELLICO No.: 1404

MAP SHEET SCALE 1:250 000 CARPELLICO

INSPECTED BY: K. Hudson DATE: 22-3-82

AUTHORITY: C.M.A. FIELD BOOK: 1995

STATION **CARGELLIGO TS 1404**

Owner's Name: **Kevin Skipworth**
 Address: **"Currah"**
 Phone: **Lake Cargelligo 30**

Current Occupant:
 Address:
 Phone:


ACCESS
 Access Report of **27/3/1982** was found suitable/unsuitable.

Freehold Land No Trig Reserve
Section 4
Parish Cargelligo
County Darling
Shire Lachlan

* Key required. Phone owner.

- 00 Post Office Lake Cargelligo Head west along Foster Street
- 06 Turn left towards West Wyalong.
- * 4-3 Owners house "Currah" on right. (Collect key)
- 55 Turn right onto gravel road.
- 61 Turn left, go through locked gate, follow track.
- 83 Turn right at gate and head to top of hill.
- 86 At trig.

Record of Station
 2WD possible if dry

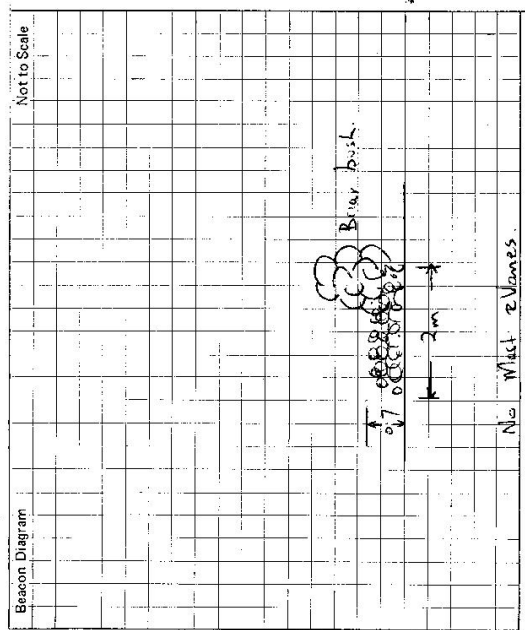

This section to be completed by officer constructing pillar.

Original station mark found/not found.

Description of mark:

Original beacon found/not found.

Description of beacon:

Height Top of Vanes to Top Mark m.

Height of mark m. above below G.L.

Diameter of Vanes m. Height of Cairn m.

Original Beacon has/has not been destroyed by me.

Date	Record of Station