

Trigonometrical Survey of N.S.W.

RECONNAISSANCE and MAINTENANCE REPORT

Department of Lands

This Trig. Station has been:-

Note: Cross out word or words which do not apply

1. Completely clear for full vision to surrounding Trigs.
2. Cleared by lines bearing See Over from Trig. Mast
3. Trig. Mast & Vanes have been painted white & black respectively.
4. The Trig. was unpiled/not unpiled, dimensions now being: Original Station Mark found / not found

Description of mark: Steel Pin in Concrete Block, should be explicit, e.g. Steel plug, Brass plug, Bolt, G.I. Pipe

Height of mark..... m ^{above} rock/concrete m ^{below} G.L.

Height of Top Vanes to Top Mark..... m. Diameter of Vanes (vertical)..... 0.61..... m.

Height of Cairn..... m. Diameter of Cairn..... m.

Length of Mast..... m. (approximate if not unpiled)

5. A..... set in conc./rock has been placed..... m. bearing..... °M from Trig. Mast
6. A..... set in conc./soil has been placed..... m. bearing..... °M from Trig. Mast
7. A..... set in conc./soil has been placed..... m. bearing..... °M from Trig. Mast
8. A..... set in conc./rock has been placed..... m. bearing..... °M from Trig. Mast

9. Connection..... to..... : m. bearing..... °M

10. Connection..... to..... : m. bearing..... °M

11. Connection..... to..... : m. bearing..... °M

12. Connection..... to..... : m. bearing..... °M

13. Diff. Ht. is..... m. ^{above} _{below}

14. Diff. Ht. is..... m. ^{above} _{below}

15. Diff. Ht. is..... m. ^{above} _{below}

16. Diff. Ht. is..... m. ^{above} _{below}

Prepared by:

Checked:

Noted on U.T.M. Card

Checked

TS 1419 CARRINGTON (S18)
STATION CARRINGTON (S18)



Co: CAMDEN Ph: WALLAYA

Map Sheet: KANGAROO VALLEY C.M.A. 1:25000 No: 9028-IV-S

Inspected by: Date: 1966

Authority: M.W.S. & D.B. Field Book:

Bench Diagram

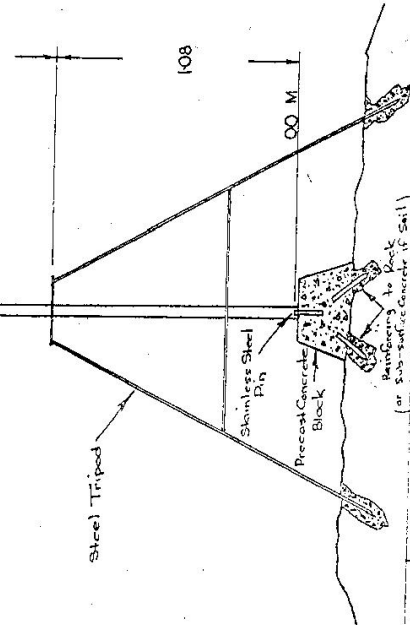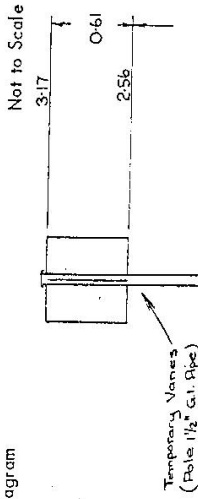

Date

Record of Station

