

CENTRAL MAPPING AUTHORITY

GEODETIC SURVEY OF M.S.W.
 GEODETIC STATION RECONNAISSANCE and MAINTENANCE REPORT

STATION: **CHALKER G.S.** No.: **1448**
 MAP SHEET SCALE 1:250 000
 INSPECTED BY: **M.L. MARRISON** DATE: **23/11/18**
 AUTHORITY: **C.M.A.** FIELD BOOK: **1711**

- Description:
- Note: Cross out word or words which do not apply*
1. Cleared by lances bearing..... from Trig. Mast
 2. Mast & Vanes have been painted w. . . & black respectively.
 3. The station/pillar was unpiled/not unpiled/constructed on..... 19..... dimensions now being:
 Description of mark..... should be explicit, e.g., S/Steel Pillar/Plate, Steel plug, Brass plug, Bolt, G.I. Pipe
 Height of mark.....m. ^{above} rock/concrete; Mark is.....m. ^{above} below G.L.
 Height of Top Vanes to Top Mark/Pillar plate.....m. Diameter of Vanes (vertical).....m.
 Height of Cairn.....m. Diameter of Cairn.....m. Name Plate found/not found/placed.
 Length of Mast.....m. (approximate if not unpiled)
 4. A.....set in conc/rock has been placed/found, bearing.....°M from Mast/Plug/Pillar
 5. A.....set in co.ck has been placed/found, bearing.....°M from Mast/Plug/Pillar
 6. A.....set in conc/rock has been placed/found, bearing.....°M from Mast/Plug/Pillar
 7. A.....set in conc/rock has been placed/found, bearing.....°M from Mast/Plug/Pillar
 8. Action required:.....

Report

*TRIS FD IN FOUR CONDITION NEEDS NEW MAST, MAST LEANING SLIGHTLY
 NO OTHER MARKS FD. A COUPLE OF DAYS CLEARING FOR THIS HILL + CROSS
 JUST PAST IT FOR 360° VISION. CROSS RIDGE WILL TO NW BLOCKING
 VISION IN THAT DIRECTION.*

Prepared by: *[Signature]* 28/11/18
 Checked: *[Signature]* 28/11/18
 Noted on U.T.M. Card

STATION **CHALKER TS-1448**


Owner's Name:
 Address:
 Phone:
 Current Occupant:
 Address:
 Phone:

ACCESS:

Access Report of 23.11.1978 was found suitable/unsuitable.
Direction
 AT INTSM. NEAR CABANAN PARK AT MURRAYAN GAVES TAKE ROAD TO MITTAGONG.
 PASS RD TO 'TALLY-GANG' ON RIGHT.
 TURN RIGHT AT ROAD PASS
 GATE TOY 'TALLY-GANG'
 PASS TRACK ON RIGHT.
 GATE
 PASS TRACK ON LEFT.
 GATE
 THROUGH GATE TAKE R.H TRACK.
 TAKE MIDDLE GATE
 GATE
 TURN LEFT TO MUM SWIR TRACK AREA VISIBLE FROM HERE
 B.P.S. 9.55, 9.50, 10.05 (JUST AFTER SHACK ON LEFT), 11.05, 12.20
 THROUGH GATE FOLLOW TRACK AROUND TO LEFT.
 THROUGH GATE TURN RIGHT AROUND ADDRESS GREER THEN FOLLOW GREER DOWN
 KEEPING IT ON YOUR LEFT (ALONG OLD F/LINE)
 THROUGH WIRE GATE TURN RIGHT FOLLOW F/LINE THEN SWIR.
 PARK TRUCK 5 to 10 mins WALK TO T.P.G.

Record of Station

St 2733-2 D. West, Government Printer

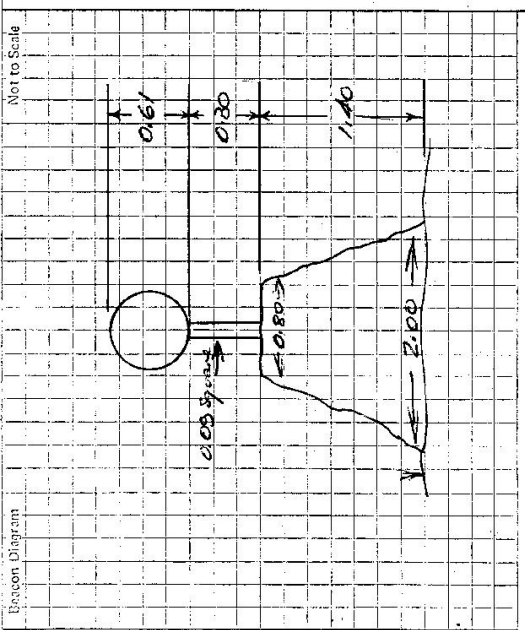

This section to be completed by officer constructing pillar.

Original station mark found/not found.

Description of mark:

Original beacon found/not found.

Description of beacon:

Height Top of Vane to Top Markm.

Height of markm. above rock/conc. below G.L.

Diameter of Vanem.

Height of Cairnm.

Original Beacon has/has not been destroyed by me.