

GEODETTIC SURVEY OF NSW

CENTRAL MAPPING AUTHORITY

GEODETTIC STATION RECONNAISSANCE and MAINTENANCE REPORT

Description:

Note: Cross out word or words which do not apply

1. Cleared by Janes bearing..... from Trig. Mast
2. Mast & Vanes have been painted white & black respectively.
3. The station/pillar was unpiled/not unpiled/constructed on.....19....., dimensions now being:
 - Description of mark.....should be explicit, e.g., S/Steel Pillar Plate, Steel plug, Brass plug, Bolt, G.I. Pipe
 - Height of mark.....m. ^{above}/_{below} rock/concrete; Mark is.....m. ^{above}/_{below} G.L.
 - Height of Top Vanes to Top Mark/Pillar plate.....m. Diameter of Vanes (vertical).....0.93
 - Height of Cairn.....1.35.....m. Diameter of Cairn.....2.7m. Name Plate found/not found/bleed.
 - Length of Mast.....3.25.....m. (approximate if not unpiled)
4. A.....set in conc/rock has been placed/found, bearing.....° M from Mast/Plug/Pillar
5. A.....set in conc/rock has been placed/found, bearing.....° M from Mast/Plug/Pillar
6. A.....set in conc/rock has been placed/found, bearing.....° M from Mast/Plug/Pillar
7. A.....set in conc/rock has been placed/found, bearing.....° M from Mast/Plug/Pillar
8. Action required:.....

STANDPOINT:

Mark	Direction	Horiz. Distance	Height Difference	Mark	Direction	Horiz. Distance	Height Difference
			above standpt.				above standpt.
			below standpt.				below standpt.
			above standpt.				above standpt.
			below standpt.				below standpt.
			above standpt.				above standpt.
			below standpt.				below standpt.
			above standpt.				above standpt.
			below standpt.				below standpt.

Prepared by: *[Signature]* 15/11/78

Checked: *[Signature]*

Noted on U.T.M. Card

ST 2733-1

STATION: *CHAPMAN* TS No.: *145B*

MAP SHEET SCALE 1:250 000

INSPECTED BY: *A.L. Morrison* DATE: *20/10/78*

AUTHORITY: *C.M.A.* FIELD BOOK: *1710*

Station Diagram

North

Not to Scale

*Trig fld in fair condition.
1 Section of vanes missing
No other marks fld.
Abt 3days clearing required (mainly
cypress pine)*

+

Checked

St 2733-3 D. West, Government Printer

STATION **CHAPMAN G.S. 1453**

Owner's Name:
 Address:
 Phone:
 Current Occupant:
 Address:
 Phone:


ACCESS

Access Report of 22/10/1978 was found suitable/unsuitable.

Direction
 Old Bengonia school head South towards Windellama.
 0.00 Turn left through gate and follow track around
 3.60 to the right.
 4.40 Turn right off track make own way up hill
 4.70 CHAPMAN G.S.

Not to Scale

Beacon Diagram

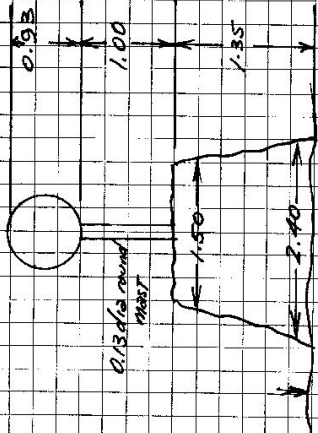

This section to be completed by officer constructing pillar.

Original station mark found/not found.

Description of mark:

Original beacon found/not found.

Description of beacon:

Height Top of Vanes to Top Markm.

Height of markm. above G.L. below rock/cone

Diameter of Vanesm.

Height of Cairnm.

Original Beacon has/has not been destroyed by me.

Date	Record of Station

CENTRAL MAPPING AUTHORITY

GEODETIC SURVEY OF N.S.W.

GEODETIC STATION RECONNAISSANCE and MAINTENANCE REPORT

- Description:
- Cleared by lanes bearing..... *Note: Cross out word or words which do not apply*
 1. ~~IMBEDDED~~..... from Trig. Mast
 - Mast & Vanes have been painted white & black respectively x
 - The station/pillar was ~~unplaced~~/not unpiled/~~constructed~~ on ~~2.1.77~~ ^{1.19.24} ~~May~~ ^{May} 19~~24~~²⁴, dimensions now being:
 Description of mark: ~~S~~ ^{LAIRN} ~~Steel~~ ^{Mast} ~~plug~~ ^{Plate} ~~Steel~~ ^{Steel} ~~plug~~ ^{plug} ~~Brass~~ ^{Brass} ~~plug~~ ^{plug} ~~Bolt~~ ^{Bolt} ~~G.L.~~ ^{G.L.} ~~Pipe~~ ^{Pipe}
 Height of mark.....m. ^{above} ~~below~~ rock/concrete; Mark is.....m. ^{above} ~~below~~ G.L.
 Height of Top Vanes to Top Mark/Pillar plate.....m. 1.5m ~~Top~~ ^{Top} Diameter of Vanes (vertical).....m. 92.2m.
 Height of Cairn.....m. Diameter of Cairn.....m. Name Plate ~~found~~/not found/~~placed~~.
 Length of Mast.....m. (approximate if not unpiled)
 - A.....set in conc/rock has been placed/found, bearing.....° M from Mast/Plug/Pillar
 - A.....set in conc/rock has been placed/found, bearing.....° M from Mast/Plug/Pillar
 - A.....set in conc/rock has been placed/found, bearing.....° M from Mast/Plug/Pillar
 - A.....set in conc/rock has been placed/found, bearing.....° M from Mast/Plug/Pillar
 - Action required:.....

STANDPOINT:			STANDPOINT:		
Mark	Direction	Horiz. Distance	Height Difference	Direction	Horiz. Distance
			above standpt.		
			below standpt.		
			above standpt.		
			below standpt.		
Prepared by: D. J. KAIN. Checked: Noted on U.T.M. Card

S: 2733--1

STATION: CHAPMAN Geodetic Station No: 1453
 MAP SHEET SCALE 1:250 000
 INSPECTED BY: D. J. KAIN DATE: 21 May 1984
 AUTHORITY: C. M. A. FIELD BOOK: 1954


Station Diagram
 Not to Scale
 The total clearing of station - 2 men with chains saws about 3 days.

STATION **CHAPMAN Geodetic Station. 1453** TS

Fred Hold
 Owner's Name: **ESTATE: MR. J. CHAPMAN.**
 Address: **LUMLEY PARK**
BUNGONIA
 Phone: **(048) 48 4282**
 21-5-1984

MANAGER:
 Current Occupant: **MR. Bob Hinchcliffe**
 Address: **LUMLEY PARK**
BUNGONIA
 Phone:

ACCESS **21-5-1984**
 Access Report of 7/20/17/19/20 was found suitable/unsuitable.
Note: Note Manager to be notified before work commences he may visit site with survey party to see extent of clearing required plus he may use some spray black trees that are tall for fence / strainer posts.
FEATURE
0.00 AT BUNGONIA POST OFFICE ON INVERARY ROAD, TRAVEL TOWARD WINDHELLAMA.
0.16 TURN LEFT TOWARD WINDHELLAMA.
4.38 THROUGH IRON GATE ON YOUR L.H.S. AT ROAD INTERSECTION "TARAGO" WINDHELLAMA. FOLLOW TRACK ACCESS ROAD TO SADDLE AND GAP IN TREES.
4.96 SADDLE AND GAP IN TREES. TURN LEFT AT BLAZED TREE AND FOLLOW BLAZED TRAIL
5.15 CHAPMAN - GEODETIC STATION.

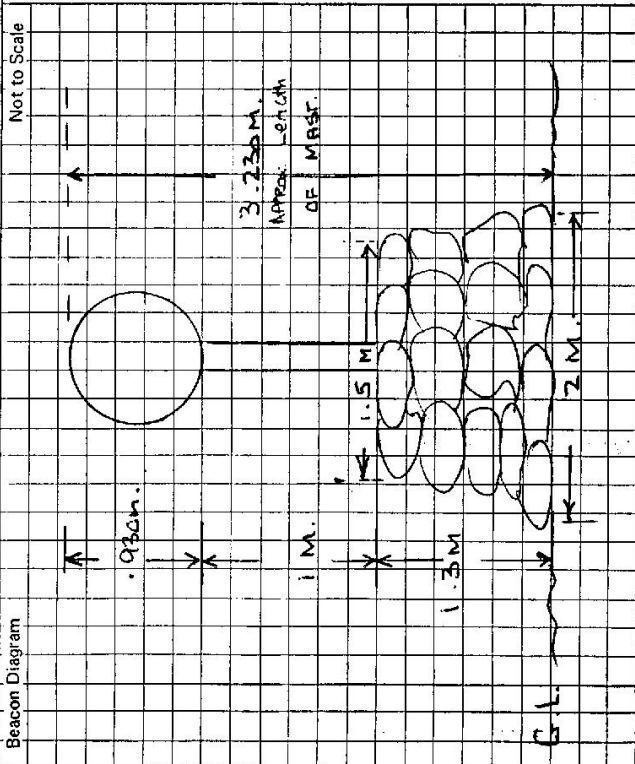

This section to be completed by officer constructing pillar.

Original station mark found/not found.

Description of mark:

Original beacon found/not found.

Description of beacon:

Height Top of Vanes to Top Markm.

Height of markm. above G.L. / below rock/conc

Diameter of Vanesm. Height of Cairnm.

Original Beacon has/has not been destroyed by ma.

Date	Record of Station