


STATION: **CHELMSFORD** No.: **1465**

MAP SHEET
SCALE 1:250 000
INSPECTED BY: **D. KINLYSIDE** DATE: **11-6-80**

AUTHORITY: **C. M. A.** FIELD BOOK: **1870**

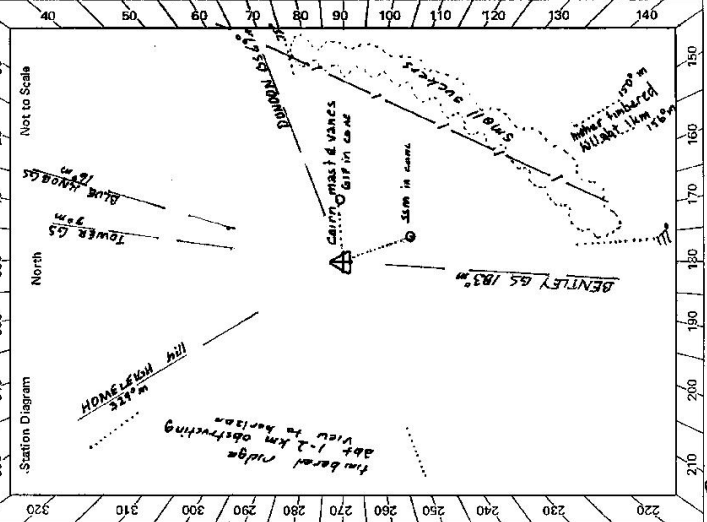

GEODETTIC STATION RECONNAISSANCE and MAINTENANCE REPORT

Description: *Note: Cross out word or words which do not apply*

1. Cleared by lances bearing..... from Trig. Mast
2. Mast & Vanes have been painted white & black respectively.
3. The station/~~was emptied~~/not unpiled/~~constructed~~ on..... 1922... dimensions now being:
Description of mark *Slightly leaning* be explicit, e.g. S/Steel Pillar Plate, Steel plug, Brass plug, Bolt, G.I. Pipe
Height of mark.....m. above below rock/concrete; Mark is.....m. above below G.L.
Height of Top Vanes to Top Mark/Pillar plate.....m. Diameter of Vanes (vertical).....m.
Height of Cairn.....m. Diameter of Cairn.....m. Name Plate ~~found~~/not found/~~found~~
Length of Mast.....m. (approximate if not unpiled)
4. A..... *G.I. Pipe*..... set in conc/~~mark~~ has been ~~placed~~/found, bearing... 86° ... 0° M from Mast/~~Steel Plate~~ *3.55 m*
5. A..... *S.S.M.*..... set in conc/~~mark~~ has been ~~placed~~/found, bearing... 162° ... 0° M from Mast/~~Steel Plate~~ *1.15*
6. A..... set in conc/rock has been placed/found, bearing..... 0° M from Mast/Plug/Pillar
7. A..... set in conc/rock has been placed/found, bearing..... 0° M from Mast/Plug/Pillar
8. Action required: *to be replaced*..... *small... suit. visit. ... for... concrete pillar*

STANDPOINT:			
Mark	Direction	Horiz. Distance	Height Difference
			above standpt.
			below standpt.
			above standpt.
			below standpt.
Prepared by: **P. Holden** 2-7-80 Checked: **D. Kinlyside**
 Noted on U.T.M. Card
 Checked: **19/1/80**

5.2735-2 D. West, Government Printer


STATION **GHEWMSFORD C.S. TS. 1465**

Owner's Name: **W.A. XFORA**
 Address: **C/O SOUTH LISMORE RD**
 Phone: **980152**

Current Occupant:
 Address:
 Phone:

ACCESS
 Access Report of 26.11.1981 was found suitable/unsuitable.

- DIR. S.W.**
- 0-0 SOUTH LISMORE RD HEADS WEST.
 - 0-1 TURN RIGHT SIGN X-ROAD 43.
 - 5-0 TURN RIGHT SIGN LANEBOOK 23 CAWONGLA 34
 - 5-6 BRIDGE
 - 6-0 TURN LEFT SIGN LANEBOOK 23 CAWONGLA 30
 - 9-9 PASS RD ON R.H.S.
 - 11-0 PASS RD ON R.H.S.
 - 13-2 PASS RD ON R.H.S.
 - 13-3 BRIDGE
 - 16-2 PASS ROCK VALLEY PUBLIC SCHOOL ON R.H.S.
 - 21-2 TURN LEFT SIGN OXFORD RD
 - 21-4 IRON GATE
 - 21-6 CHANGERS HOUSE ON R.H.S. HEAD UP BETWEEN HOUSE + SHED
 - 21-7 THROUGH IRON GATE
 - 21-8 THROUGH IRON GATE
 - 22-3 WEER RIGHT TOWARDS SHED
 - 22-4 SHED ON L.H.S.
 - 22-9 DAM ON R.H.S.
 - 23-0 TURN LEFT AROUND LONE TREE + HEAD UP RIDGE
 - 23-2 WIRE GATE THEN SHARP TURN LEFT THEN FOLLOWS TOP OF RIDGE
 - 23-6 ACROSS SADDLE AND WEER RIGHT UP ALONG EDGE OF TIMBER
 - 23-8 WEER RIGHT TRACK ZIG-ZAG UP SIDE OF HILL
 - 24-1 STRAIGHT AHEAD
 - 24-4 ROCKY SECTION ABOUT 50M BEFORE TRIC.

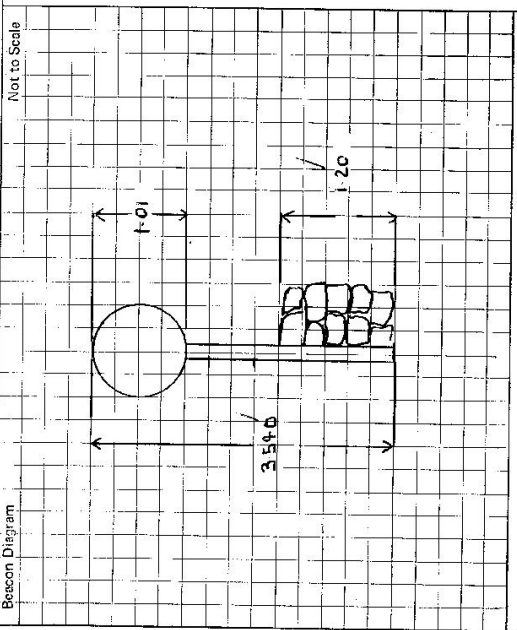

This section to be completed by officer constructing pillar.

Original station mark found/~~not found~~.

Description of mark: **GLASS PLACQUE**

Original beacon found/~~not found~~.

Description of beacon: **CAMP MAST + JAMES**

Height Top of Vanes to Top Mark: **3-54-0** m.

Height of mark: **5-5-0** m. above / below G.L.

Diameter of Vanes: **0-1** m. Height of Cairn: **1-20** m.

Original Beacon ~~has~~ has not been destroyed by me.

Date	Record of Station

