

7-4-98

TRIGONOMETRICAL SURVEY OF N.S.W.
 RECONNAISSANCE and MAINTENANCE REPORT

CENTRAL MAPPING AUTHORITY
 Department of Lands

STATION CHESTER GAP TS-1468

Co: EDWINESTER Ph: TILLEGRA

Map Sheet: DUNGGEE No: 9233 V

Inspected by: P. CHEN Date: 20/1/77

Authority: C.M.A Field Book: 1565

Beacon Diagram Not to Scale

This Trig. Station has been:- Note: Cross out word or words which do not apply

1. Completely cleared to permit 360° vision to surrounding Trigs.
2. Cleared by lances bearing from Trig. Mast
3. Trig. Mast & Vanes have been painted white & black respectively.
4. The Trig. was unpiled/not unpiled, dimensions now being: Original Station Mark found, not found

Description of mark..... should be explicit, e.g. Steel plug, Brass plug, Bolt, G.I. Pipe

Height of mark..... m above rock/concrete m below G.L.

Height of Top Vanes to Top Mark..... m. Diameter of Vanes (vertical)..... m.

Height of Cairn..... m. Diameter of Cairn..... m.

Length of Mast..... m. (approximate if not unpiled)

5. A..... set in conc/rock has been placed..... m. bearing.....°M from Trig. Mast
6. A..... set in conc/soil has been placed..... m. bearing.....°M from Trig. Mast
7. A..... set in conc/soil has been placed..... m. bearing.....°M from Trig. Mast
8. A..... set in conc/rock has been placed..... m. bearing.....°M from Trig. Mast

9. Connection..... to..... m. bearing.....°M

10. Connection..... to..... m. bearing.....°M

11. Connection..... to..... m. bearing.....°M

12. Connection..... to..... m. bearing.....°M

13. Diff. Hr. is..... m. above below

14. Diff. Hr. is..... m. above below

15. Diff. Hr. is..... m. above below

16. Diff. Hr. is..... m. above below

N/L

Date Record of Station


Prepared by: P. CHEN Checked: N/L Noted on U.T.M. Card

Checked

STATION CHICHESTER GAP TS - 1468

Owners Name.....
 Current Occupant.....
 Address.....
 Address.....

Access KM 20-4-1971 REMARKS
 2.0 AT DUNTOF. TRAVELING NORTH ON DOWLING ST. TURN LEFT AT WHITE CONCRETE SIGN POST
 AND FOLLOW ROAD SIGN TO BARRINGTON HOUSE & CHICHESTER DAM.
 7.4 INTERSECTION. TAKE ROAD TO LEFT SIGN BARRINGTON HOUSE - UPPER CHICHESTER SALISBURY
 10.0 CROSS BRIDGE.
 12.1 T. INTERSECTION. PASS MYHILL CREEK ROAD ON LEFT. GO STRAIGHT AHEAD.
 13.2 CROSS WOODEN BRIDGE.
 16.8 CROSS "MINNI" BRIDGE.
 17.9 CROSS WOODEN BRIDGE.
 20.3 TAKE RIGHT FORK & FOLLOW BITUMEN ROAD.
 20.4 (ROSS WOODEN BRIDGE.
 21.9 T. INTERSECTION. TURN RIGHT TAKE ROAD TO CHICHESTER.
 24.4 CROSS WOODEN BRIDGE.
 26.1 END OF BITUMEN.
 28.5 CROSS WOODEN BRIDGE.
 28.9 SLIP RAIL FENCE ON LEFT. GO THROUGH & FOLLOW FENCE LINE UP AND OVER RIDGE.
 29.0 CLUSTER OF TREE. PASS THRU. & FOLLOW RIDGE DOWN.
 PARK VEHICLE. WALK UP TO THE HILL. FOLLOWING FENCE LINE. TURN LEFT. TRIG
 ON NEXT HILL. [I CAN DRIVE TO TRIG IN DRY WEATHER.]

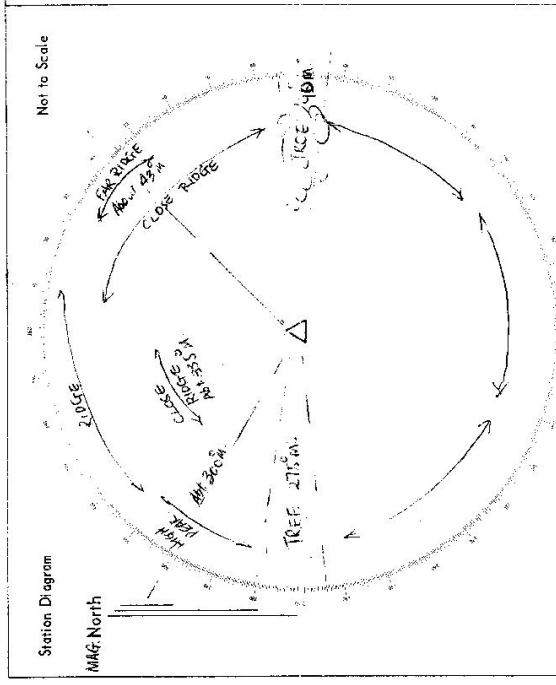

List of Observed Directions:-

Standpoint:	
Station	Direction

Standpoint:	
Station	Direction