

75-193

Department of Lands  
 Integrative Reconnaissance and Maintenance Report  
 Station: **CHICK (P)** TS **1469**  
 Co: **Northumberland** Ph: **Roxburgh**  
 Map Sheet: **Branxton 1:50 000** No:  
 Inspected by: **P. McBeath** Date: **6.7.76**  
 Authority: **I.S.D. N.C.L.E.** Field Book: **PPP328**  
 Beacon Diagram

Date	Record of Station

This Trig. Station has been:-  
 Note: Cross out word or words which do not apply

1. Completely cleared to permit 360° vision to surrounding Trigs. ✓  
 2. Cleared by ~~tones-bearing~~ from Trig. Mast  
 3. Trig. Mast & Vanes have been painted white & black respectively. ✓  
 4. The Trig. was unpiled/~~not-emptied~~, dimensions now being:  
 Description of mark: Concrete Pillar should be explicit, e.g. Steel plug, Brass plug, Bolt, Concrete Pillar  
 Height of mark: 1.28 m <sup>above</sup> ~~below~~ concrete 1.28 m <sup>above</sup> ~~below~~ G.L.  
 Height of Top Vanes to ~~Top Plate~~ Top pillar plate 1.95 m Diameter of Vanes (vertical) 0.75 m.  
 Height of Cairn: 1.28 m. Diameter of Cairn: 33/55 m.  
 Length of Mast: 2.06 m. (~~approximately not emptied~~)  
 5. A. S.S. Pin set in conc/~~rock~~ has been placed/fd 2.388 m, bearing 269 °M from Trig. Mast/pillar  
 6. A. Rod set in conc./soil has been placed/fd 5.34 m, bearing 101 °M from Trig. Mast/pillar  
 7. A. G.I.P. set in conc./soil has been placed/fd 2.093 m, bearing 176 °M from Trig. Mast/pillar  
 8. A. set in conc./rock has been placed/fd ..... m, bearing ..... °M from Trig. Mast/pillar  
 9. Connection: S.S. Pin to Rod : 7.832 m, bearing 96 °M  
 10. Connection: S.S. Pin to G.I.P. : 3.355 m, bearing 126 °M  
 11. Connection: ..... to ..... : ..... m, bearing ..... °M  
 12. Connection: ..... to ..... : ..... m, bearing ..... °M  
 13. Diff. Ht. Pillar Mast is 1.209 m <sup>above</sup> S.S. Pin  
 14. Diff. Ht. Pillar Plate is 1.552 m <sup>above</sup> Rod  
 15. Diff. Ht. Pillar Plate is 1.321 m <sup>above</sup> G.I.P.  
 16. Diff. Ht. Pillar Plate is ..... m <sup>above</sup> G.I.P.  
 Prepared by: APB Checked: Alan Burrows

STATION **CHICK (P)** TS 1469

Owners Name **located on Public Road.** Current Occupant

Address

Access **6-7-76**

Km. **Feature.**


0-0 **Vincent St and Main St Cornock. (Truned towards Bellbird)**

0-1 **Turn right Sign "Singleton"**

7-1 **Turn left Sign "Potolbin, Broke"**

8-15 **Trig is on R.H.S of Road at top of High Bank. (It is possible to drive up slope to Trig)**

**keys: By Loked drive vehicle.**

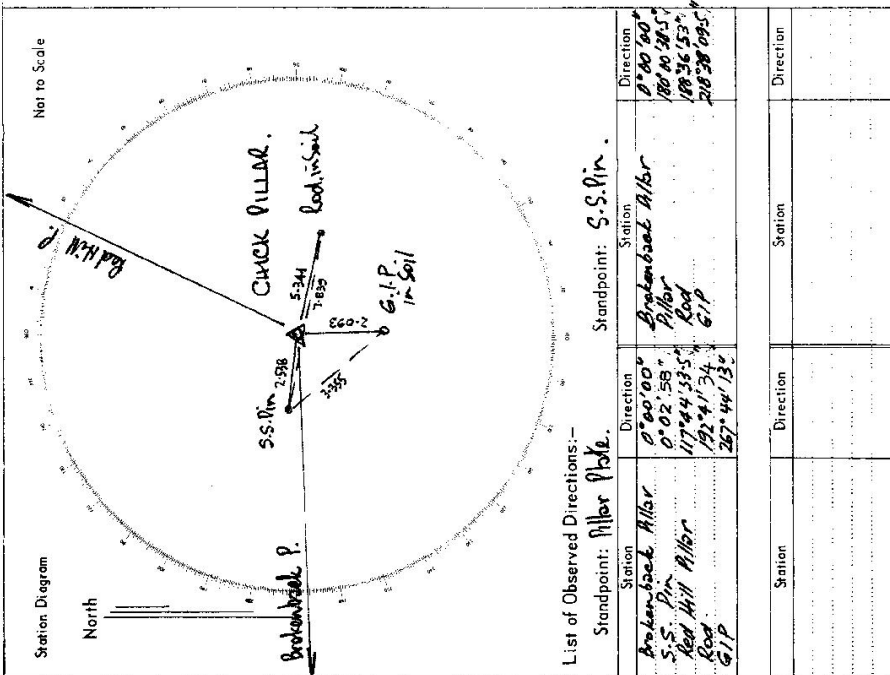

CENTRAL MAPPING AUTHORITY

GEODETIC SURVEY OF M.S.W.

GEODETIC STATION RECONNAISSANCE and MAINTENANCE REPORT

Description:

1. Cleared ~~by~~ 360 <sup>o</sup> ~~from~~ Trig. Mast Pillar.  
*Note: Cross out word or words which do not apply*
2. Mast & Vanes have been pairred white & black respectively.  Inspected, Mast & Vanes were repainted on 12 April 1979, dimensions now being: The station/pillar was 12 April 1979, dimensions now being: St. Steel Cap 310x300 were attached to pillar plate.  
Description of marks: St. Steel Cap should be explicit, e.g., S/Steel Pillar Plate, Steel plug, Brass plug, Bolt, G.I. Pipe
3. St. Steel Cap 310x300 were attached to pillar plate.  
Height of mark: 1.286 m. <sup>above</sup> concrete; <sup>below</sup> G.L.  
Height of Top Vanes to Top Mast/Pillar plate 1.958 m. Diameter of Vanes (vertical) 0.750 m.  
Height of Cairn: 2.060 m. Diameter of Cairn: 0.300 m. Name Plate found/replaced/placed,  
Length of Mast 2.060 m. (approximate if not measured) C.M.A. Geodetic Station,  
Chick T.S.
4. A set in conc/rock has been placed/found, bearing: 191.2 ° M from Mast/Plug/Pillar 1972
5. A set in conc/rock has been placed/found, bearing: 191.2 ° M from Mast/Plug/Pillar
6. A set in conc/rock has been placed/found, bearing: 191.2 ° M from Mast/Plug/Pillar
7. A set in conc/rock has been placed/found, bearing: 191.2 ° M from Mast/Plug/Pillar
8. Action required: None

STANDPOINT:

Mark	Direction	Horiz. Distance	Height Difference	Mark	Direction	Horiz. Distance	Height Difference
			above standpt				above standpt
			below				below
			above standpt				above standpt
			below				below
Prepared by: PKA Checked: PKA Noted on U.T.M. Card

SI 2738-1

STATION: CHICK (Pillar) No: 1469

MAP SHEET SCALE 1:250 000 SINGLETON

INSPECTED BY: D.F. Kain DATE: 12 April 1979

AUTHORITY: C.M.A. FIELD BOOK: 1673


Station Diagram
North
Not to Scale

STATION **CHICK (Pillar) TS 1469**

Owner's Name: .....  
 Address: .....  
 Phone: .....

Current Occupant: .....  
 Address: .....  
 Phone: .....

ACCESS  
 Access Report of **12.4.1978** was found suitable/unsuitable.

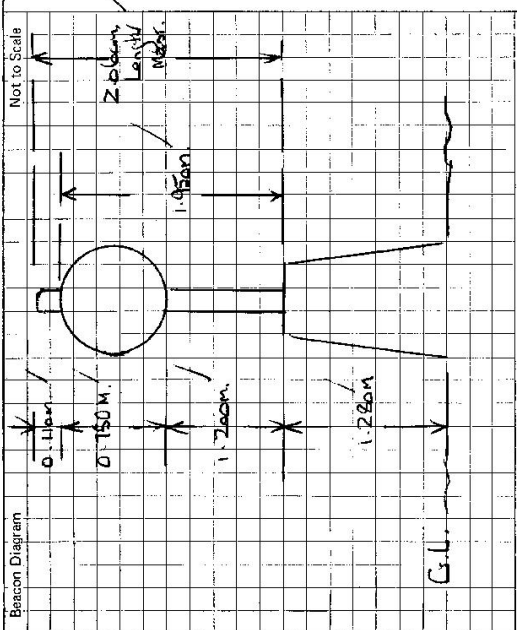

This section to be completed by officer constructing pillar.

Original station mark found/not found.

Description of mark: .....

Original beacon found/not found.

Description of beacon: .....

Height Top of Vane to Top Mark .....m.

Height of mark .....m. above rock/core .....m. below G.L.

Diameter of Vane .....m.

Original Beacon has/has not been destroyed by me.

Date	Record of Station

CENTRAL MAPPING AUTHORITY

GEODETTIC SURVEY OF N.S.W.

GEODETTIC STATION RECONNAISSANCE and MAINTENANCE REPORT

Description:

Note: Cross out word or words which do not apply

1. Cleared by lanes bearing..... from Trig. Mast
2. Mast & Vanes have been painted white & black respectively. **NEW MAST & VANES only**
3. The station/pillar was unpiled/not unpiled/constructed on.....<sup>above</sup>.....<sup>below</sup>.....<sup>19</sup>....., dimensions now being: Description of mark..... should be explicit, e.g., S/Steel Pillar Plate. Steel plug, Brass plug, Bolt, G.I. Pipe  
 Height of mark.....<sup>above</sup>.....<sup>below</sup>..... m. rock/concrete; Mark is.....<sup>above</sup>.....<sup>below</sup>..... m. G.L.  
 Height of Top Vanes to Top ~~Mast~~/Pillar plate **1.48**..... m. Diameter of Vanes (vertical) **0.75**..... m.  
 Height of Cairn..... m. Diameter of Cairn..... m. Name Plate found/not found/placed.  
 Length of Mast..... m. (approximate if not unpiled)
4. A..... set in conc./rock has been placed/found, bearing.....°M from Mast/Plug/Pillar
5. A..... set in conc./rock has been placed/found, bearing.....°M from Mast/Plug/Pillar
6. A..... set in conc./rock has been placed/found, bearing.....°M from Mast/Plug/Pillar
7. A..... set in conc./rock has been placed/found, bearing.....°M from Mast/Plug/Pillar
8. Action required:.....

STANDPOINT:

STANDPOINT:

Mark	Direction	Horiz. Distance	Height Difference	Mark	Direction	Horiz. Distance	Height Difference
			above standpt				above standpt
			below				below
			above standpt				above standpt
			below				below
Prepared by: **KJ**

Checked: **3-5-85**

Noted on U.T.M. Card **KJ**

STATION: **CHICK** No.: **169**

MAP SHEETS SCALE 1:250 000 **NEWCASTLE** SCALE 1:100 000 **CESSENDEN**

INSPECTED BY: **SCB (NEWCASTLE)** DATE: **28-3-85**

AUTHORITY: **CMA** FIELD BOOK:

Checked: **14/1 3/85**