

GEODETTIC SURVEY OF NSW

CENTRAL MAPPING AUTHORITY

GEODETTIC STATION RECONNAISSANCE and MAINTENANCE REPORT


STATION: **CLEMSON** No.: **1488**

MAP SHEET SCALE 1:250 000 **CARGELLIGO**

INSPECTED BY: **G. C. HANNA** DATE: **22/5/19**

AUTHORITY: **C. M. A.** FIELD BOOK:

- Description:
- Note: Cross out word or words which do not apply*
1. Cleared by lanes bearing..... from Trig, Mast
 2. Mast & Vanes have been painted white & black respectively.
 3. The station/pillar was unpiled/hot unpiled/constructed on..... 19..... dimensions now being:
Description of mark..... should be explicit, e.g., S/Steel Pillar Plate, Steel plug, Brass plug, Bolt, G.I. Pipe
Height of mark..... m. ^{above} _{below} rock/concrete; Mark is..... m. ^{above} _{below} G.L.
Height of Top Vanes to Top Mark/Pillar plate m. Diameter of Vanes (vertical)..... m.
Height of Cairn..... m. Diameter of Cairn..... m. Name Plate found/not found/placed.
Length of Mast..... m. ~~Approximate if not unpiled~~
 4. A..... set in conc/rock has been placed/found, bearing..... °M from Mast/Plug/Pillar
 5. A..... set in conc/rock has been placed/found, bearing..... °M from Mast/Plug/Pillar
 6. A..... set in conc/rock has been placed/found, bearing..... °M from Mast/Plug/Pillar
 7. A..... set in conc/rock has been placed/found, bearing..... °M from Mast/Plug/Pillar
 8. Action required:.....

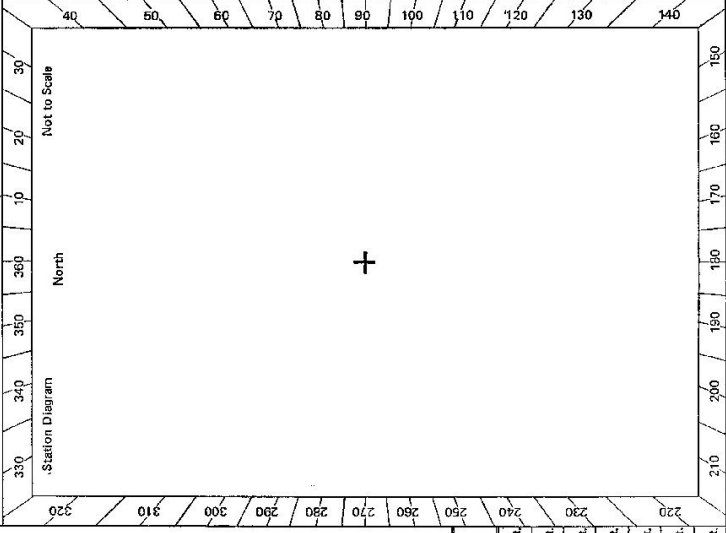


STANDPOINT:

Mark	Direction	Horiz. Distance	Height Difference	Mark	Direction	Horiz. Distance	Height Difference
			above standpt				above standpt
			below standpt				below standpt
			above standpt				above standpt
			below standpt				below standpt
Prepared by: *G. Hanna 22/5/19* Checked: *[Signature]* Noted on U.T.M. Cart

St 2735-2 D. West, Government Printer

STATION CLEMSON TS 1488

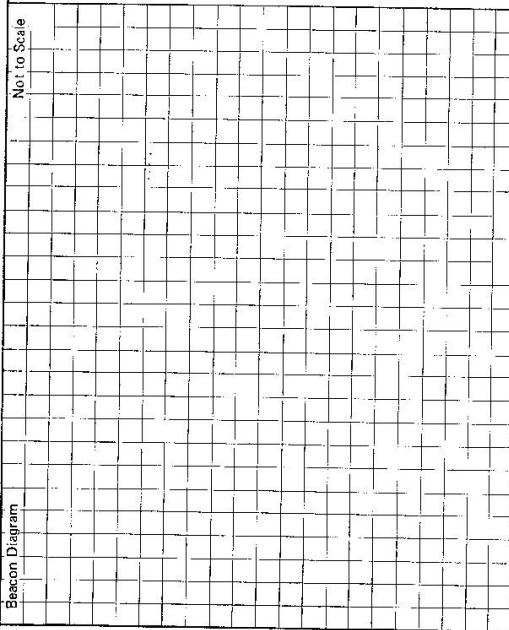

Owner's Name:
 Address:
 Phone:
 Current Occupant:
 Address:
 Phone:

ACCESS

Access Report of 22.1.2019. It was found suitable/unsuitable.

Cairn seen from North. Mast & vanes not in evidence.
Drive to.
No clearing required
Previously visited in 1971.
See also Tullibigeal 8231-S

This section to be completed by officer constructing pillar.

Original station mark found/not found.

Description of mark:

Original beacon found/not found.

Description of beacon:

Height Top of Vanes to Top Markm.

Height of markm. above rock/concm. below G.L.

Diameter of Vanesm. Height of Cairnm.

Original Beacon has/has not been destroyed by me.

Date	Record of Station