

CENTRAL MAPPING AUTHORITY

GEODETIC SURVEY OF N.S.W.

GEODETIC STATION RECONNAISSANCE and MAINTENANCE REPORT

Description:

- 1. Cleared by lanes bearing..... *Scattered Medium timber on hill*..... from Trig. Mast
- 2. Mast & Vanes have been painted white & black respectively.
- 3. The station/pillar was unpiled/not unpiled/constructed on.....19....., dimensions now being:

Description of mark.....should be explicit, e.g., S/Steel Pillar Plate, Steel plug, Brass plug, Bolt, G.I. Pipe

Height of mark.....m..... above G.L. Mark is.....m..... above G.L.

Height of Top Vanes to Top Mark/Pillar plate.....m. Diameter of Vanes (vertical).....m.

Height of Cairn.....m. Diameter of Cairn.....m. Name Plate found/not found/placed.

Length of Mast.....m. (approximate if not unpiled)

4. A.....set in conc/rock has been placed/found, bearing.....°M from Mast/Plug/Pillar

5. A.....set in conc/rock has been placed/found, bearing.....°M from Mast/Plug/Pillar

6. A.....set in conc/rock has been placed/found, bearing.....°M from Mast/Plug/Pillar

7. A.....set in conc/rock has been placed/found, bearing.....°M from Mast/Plug/Pillar


8. Action required: *No marks found. Hill is of little value.*

STANDPOINT:

Mark	Direction	Horiz. Distance	Height Difference	Mark	Direction	Horiz. Distance	Height Difference
			above standpt.				above standpt.
			below				below
			above standpt.				above standpt.
			below				below

Prepared by: *A. Garside* 9/9/15. Checked: *Checked*

St 2733-1

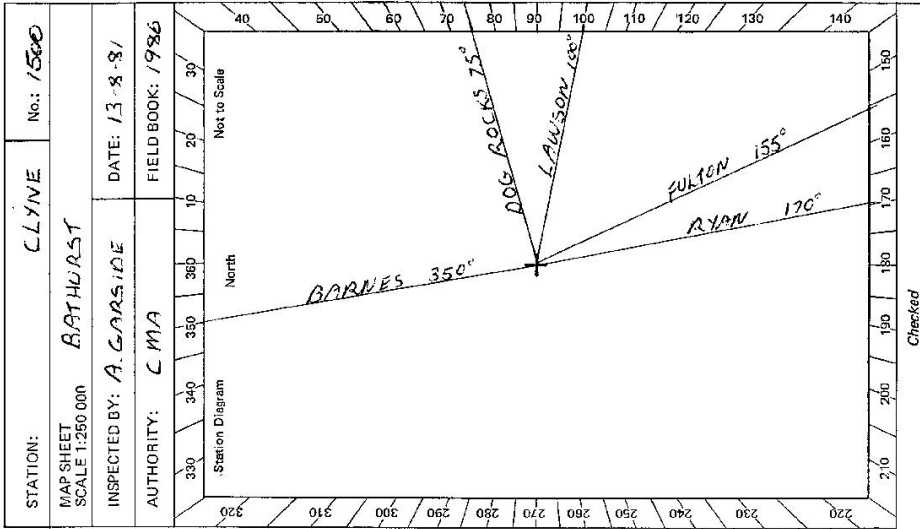

Checked

S: 2733 2 D. West, Government Printer

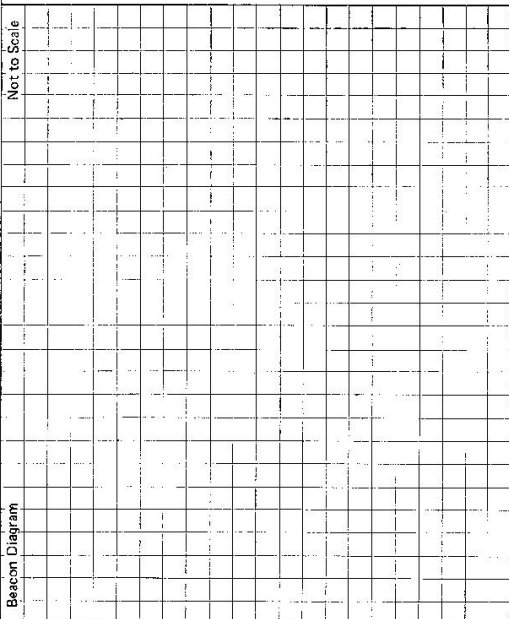Beacon Diagram 	STATION <p style="text-align: center; font-weight: bold;">CLYNE TS- 1500</p>	Owner's Name: <u>A. RANASALEY</u> Address: <u>ALYN ST. GARIBOLDI</u> Phone: <u>379954</u> Current Occupant: ..... Address: ..... Phone: ..... Access Report of <u>18/10/1987</u> was found at <u>site/tables/ranasaleya</u> ACCESS Kms 0.0 0.4 2.4 2.45 2.7 3.1 3.35 FEATURE INTERSECTION AT TRIANGLE FLAT TAKE ROAD TO ROCKLEY IS PASS OWNERS HOUSE ON LEFT TURN LEFT OFF ROAD JUST AFTER CUTTING THROUGH LOCKED IRON GATE (CHAIN CAN BE LIFTED OVER POST) VEER RIGHT TOWARDS OLD DEAD TREE CROSS LOW AREA AND FOLLOW SHEEP TRACKS UP TO SADDLE VEER LEFT UP HILL CLYNE GS
This section to be completed by officer constructing pillar. Original station mark found/not found. Description of mark: ..... Original beacon found/not found. Description of beacon: ..... Height Top of Vanas to Top Mark: .....m. Height of mark: .....m. above G.L. below Diameter of Vanes: .....m. Height of Cairn .....m. Original Beacon has/has not been destroyed by me.		Date Record of Station