

CENTRAL MAPPING AUTHORITY GEODETTIC SURVEY OF N.S.W. STATION: **CUBCROFT TS** No.: **1514**

GEODETTIC STATION RECONNAISSANCE and MAINTENANCE REPORT

MAP SHEET SCALE 1:250 000 **SINGLETON**
 INSPECTED BY: **G JONES** DATE: **23-4-80**
 AUTHORITY: **CMA** FIELD BOOK: **01880**

Description:
 1. Cleared by lanes bearing.....
 Note: Cross out word or words which do not apply from Trig. Mast
 2. Mast & Vanes have been painted white & black respectively.
 3. The station/pillar was unpiled/not unpiled/constructed on.....19....., dimensions now being:
 Description of mark.....should be explicit, e.g., S/Steel Pillar Plate, Steel Plug, Brass plug, Bolt, G.I. Pipe
 Height of mark.....m. ^{above} _{below} rock/concrete; Mark is.....m. ^{above} _{below} G.L.
 Height of Top Vanes to Top Mark/Pillar plate.....m. Diameter of Vanes (vertical).....m.
 Height of Cairn.....m. Diameter of Cairn.....m. Name Plate found/not found/placed.
 Length of Mast.....m. (approximate if not unpiled)


4. A.....~~set in conc/rock has been placed/found, bearing.....° M from Mast/Plug/Pillar~~
 5. A.....~~set in conc/rock has been placed/found, bearing.....° M from Mast/Plug/Pillar~~
 6. A.....~~set in conc/rock has been placed/found, bearing.....° M from Mast/Plug/Pillar~~
 7. A.....~~set in conc/rock has been placed/found, bearing.....° M from Mast/Plug/Pillar~~
 8. Action required:.....

STANDPOINT:			
Mark	Direction	Horiz. Distance	Height Difference
			above standpt
			below standpt
			above standpt
			below standpt
Prepared by: *J. Gayman* Checked: *Gayman* 17 Noted on U.T.M. Card

Checked

S1 2739-1

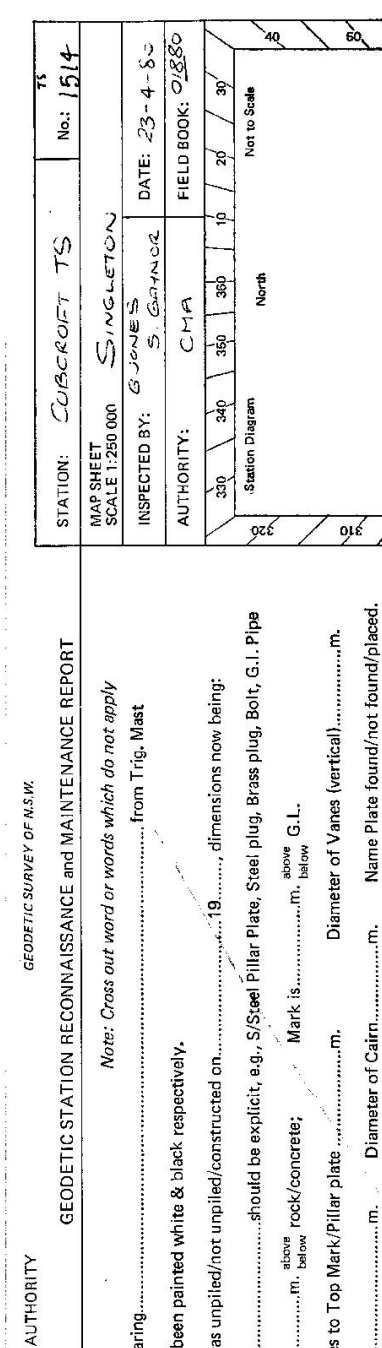

STATION **COBOROFT TS 1514**

Owner's Name: **WOLLEMI NAT PARK**
 Address:
 Phone:

Current Occupant:
 Address:
 Phone:

ACCESS

Access Report of **23.4/1988** was found suitable/unsuitable.

- 0 00 COLD RIVER BRIDGE ON PUTTY ROAD. Travel toward Singleton /
- 08 72 SIGN "PUTTY G, SINGLETON ST, WINDSOR 91" /
- 0 00 At turnoff to Putty, turn left & travel toward PUTTY
- 1 75 Turn right over road /
- 2 19 Turn left
- 2 36 Wooden bridge
- 2 43 Grid
- 3 16 Grid
- 4 21 Timber mill on left /
- 4 43 Turn left, Follow track up valley
- 4 96 Take right fork toward gate
- 5 02 Locked gate, gate 100m to south maybe used
- 5 07 Wooden bridge
- 8 04 Iron gate /
- 8 76 Iron gate
- 9 14 Grid

- 10 28 Take right fork /
- 12 64 Pass track on left /
- 13 60 Turn left /
- 13 95 Pass track on left /
- 16 08 Follow track around to left /
- 17 27 Turn on right in timber

at blazed trees on both sides of track

Possible access by 2 wheel drive.

Beacon Diagram	Not to Scale
Cairn, Most and yours found in poor condition	

This section to be completed by officer constructing pillar.

Original station mark found/not found.
 Description of mark:
 Original beacon found/not found.
 Description of beacon:
 Height Top of Varies to Top Markm.
 Height of markm. above G.L. below
 Diameter of Variesm. Height of Cairnm.
 Original Beacon has/has not been destroyed by me.

Date	Record of Station