

CENTRAL MAPPING AUTHORITY GEODETTIC SURVEY OF N.S.W.

**GEODETTIC STATION RECONNAISSANCE and MAINTENANCE REPORT**

STATION: **COBRABALD** No.: **1517**

MAP SHEET SCALE 1:250 000 **BEGA**

INSPECTED BY: **G. KEEP** DATE: **24/5/80**

AUTHORITY: \_\_\_\_\_ FIELD BOOK: \_\_\_\_\_

Station Diagram

Description:

1. Cleared by lanes bearing..... *Note: Cross out word or words which do not apply*

2. Mast & Vanes have been painted white & black respectively.

3. The station/pillar was unpiled/not unpiled/constructed on..... 19....., dimensions now being:

Description of mark..... should be explicit, e.g. S/Steel Pillar Plate, Steel plug, Brass plug, Bolt, G.I. Pipe

Height of mark.....<sup>above</sup> below rock/concrete; Mark is.....<sup>above</sup> below G.L.

Height of Top Vanes to Top Mark/Pillar plate.....m. Diameter of Vanes (vertical).....m.

Height of Cairn.....m. Diameter of Cairn.....m. Name Plate found/not found/placed.

Length of Mast.....m. (approximate if not unpiled)

4. A.....set in conc/rock has been placed/found, bearing.....° M from Mast/Plug/Pillar

5. A.....set in conc/rock has been placed/found, bearing.....° M from Mast/Plug/Pillar

6. A.....set in conc/rock has been placed/found, bearing.....° M from Mast/Plug/Pillar

7. A.....set in conc/rock has been placed/found, bearing.....° M from Mast/Plug/Pillar

8. Action required: **Old wooden quadrangle lying on top on SMA mark will need to be removed**


STANDPOINT:			
Mark	Direction	Horiz. Distance	Height Difference
			above standpt.
			below
			above standpt.
			below
Prepared by: **G. Keep 24/7/80** Checked: \_\_\_\_\_

Noted on U.T.M. Card

ST 2733-2 D. West. Government Printer

STATION COBRABALD TS 1517

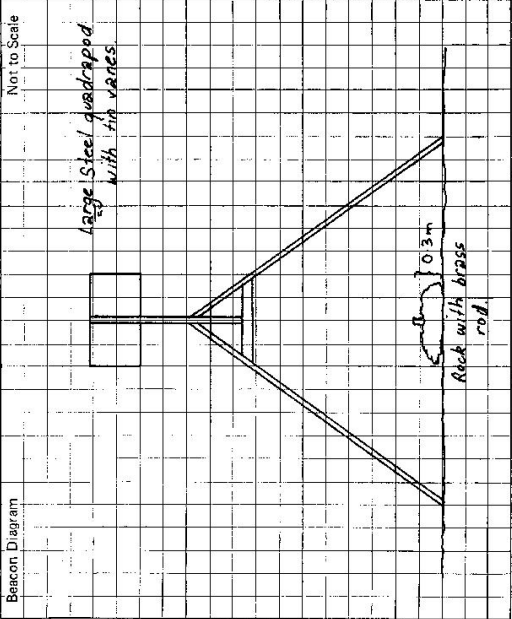

Owner's Name: .....  
 Address: .....  
 Phone: .....

Current Occupant: .....  
 Address: .....  
 Phone: .....

ACCESS

Access Report of 24/5/1983 was found suitable/unsuitable.  
 From Jindabyne P.O. travel toward Cooma  
 for 13.2 km. Turn left toward Eucumbene Dam.  
 Follow road past Eucumbene Dam turn off towards  
 Braemar Caravan Park. See owner of property  
 on right hand side of road 1 km before reaching  
 Braemar Caravan Park.  
 480 metres before entrance to owners property,  
 track to right with gate (sometimes locked).  
 From that gate -

- 0.00 Gate.
- 0.54 Gate
- 1.89 Grid.
- 3.16 Track and gate to left.
- 3.73 Grid.
- 4.31 4WD track to right. Take this track which leads to top of ridge and trig.

Note: 4WD track from  
 main track to top  
 of ridge was marked  
 at time because of  
 1080 poisoning of rabbits

Station in good order.

This section to be completed by officer constructing pillar.

Original station mark found/not found. ....

Description of mark: .....

Original beacon found/not found. ....

Description of beacon: .....

Height Top of Vanes to Top Mark .....m.  
 above G.L.  
 below

Height of mark .....m.  
 above G.L.  
 below

Diameter of Vanes .....m. Height of Cairn .....m.

Original Beacon has/has not been destroyed by me.

Date	Record of Station