

LAND INFORMATION CENTRE

GEODETTIC SURVEY OF A.S.W.

GEODETTIC STATION: RECONNAISSANCE and MAINTENANCE REPORT

STATION: COBRAM SILO

No.: 1518

MAP SHEET  
SCALE 1:250 000

INSPECTED BY: A. Sivertsen

DATE: Nov 94

AUTHORITY: LIC

FIELD BOOK: —

Description:

1. Cleared by Janes bearing..... Note: Cross out word or words which do not apply from Trig. Mast

2. Mast & Vanes have been painted white & black respectively.

3. The station/pillar was unpiled/not unpiled/constructed on..... 19....., dimensioned how being:

Description of mark..... should be explicit, e.g., S/Steel Pillar Plate, Steel plug, Brass plug, Bolt, G.I. Pipe

Height of mark.....m. above rock/concrete; Mark is.....m. above G.L.

Height of Top Vanes to Top Mark/Pillar plate.....m. Diameter of Vanes (vertical).....m.

Height of Cairn.....m. Diameter of Cairn.....m. Name Plate found/not found/placed.

Length of Mast.....m. (approximate if not supplied)

4. A.....set in conc/rock has been placed/found, bearing.....°M from Mast/Plug/Pillar

5. A.....set in conc/rock has been placed/found, bearing.....°M from Mast/Plug/Pillar

6. A.....set in conc/rock has been placed/found, bearing.....°M from Mast/Plug/Pillar

7. A.....set in conc/rock has been placed/found, bearing.....°M from Mast/Plug/Pillar

8. Action required:.....

STANDPOINT:


STANDPOINT:


Mark	Direction	Horiz. Distance	Height Difference	Mark	Direction	Horiz. Distance	Height Difference
			above standpt.				above standpt.
			below				below
			above standpt.				above standpt.
			below				below
Prepared by:

Checked: Noted on L.T.M. Card

Checked:

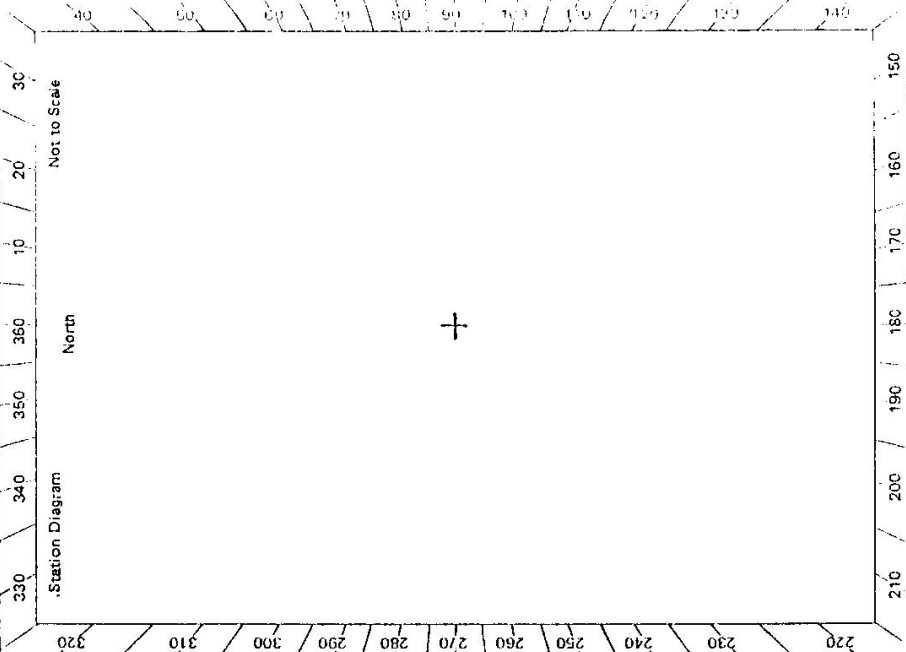

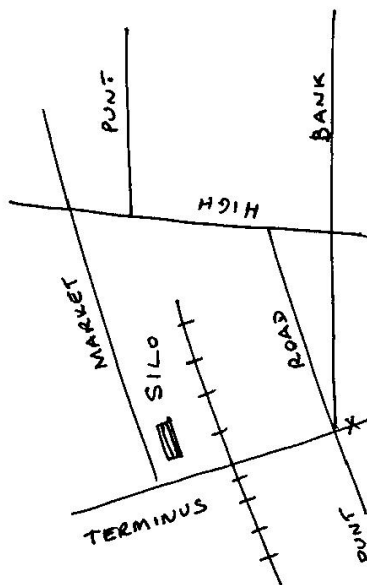2732-2 D. West, Government Printer Beacon Diagram	STATION <b>COBRAM SILO TS 1518</b> Owner's Name: <b>GRAIN ELEVATOR BOARD</b> Address: <b>CL GREG SHARPE</b> <b>PIER ST YARRAWONGA</b> Phone: <b>0507 441231</b> ← <b>NOV 94</b> ACCESS Access Report of: <b>1994</b> was found suitable/unsuitable.	Not to Scale [Empty grid for diagram]	 <p>Diagram labels: TERMINUS, MARKET ROAD, SILO, HIGH BANK, PUNT</p>
This section to be completed by officer constructing pillar. Original station mark found/not found.			Date
Description of mark: ..... Original beacon found/not found.			Record of Station
Description of beacon: ..... Height Top of Vanes to Top Mark.....m. Height of mark.....m. above rock/conc.....m. below G.L. Diameter of Vanes .....m. Height of Cairn .....m.			
Original Beacon has/has not been destroyed by me.			