

7503

TS 1523  
 (Cockatoo Hill)  
 Ph: ROCK HILL  
 No: 8931  
 Date: 14-7-75  
 Field Book: CBL 37  
 Not to Scale

STATION SSM 20464  
 Co: COOK  
 Map Sheet: WALLERAWANG  
 Inspected by: L.M HAYES  
 Authority: DEPT OF LANDS  
 Beacon Diagram

Department of Lands  
 Integration Su of N.S.W.  
 RECONNAISSANCE and MAINTENANCE REPORT  
 Note: Cross out word or words which do not apply

This Trig. Station has been:-  
 1. Completely cleared to permit 360° vision to surrounding Trigs.  
 2. Cleared by lane bearing Ext to N.W. from Trig. Mast  
 3. Trig. Mast & Vanes have been painted white & black respectively.  
 4. The Trig. was emptied not emptied, dimensions now being:

Description of mark: SSM 20464 in CONC. should be explicit, e.g. Steel plug, Brass plug, Bolt, Concrete Pillar  
 Height of mark: m above rock-concrete m below G.L.  
 Height of Top Vanes to Top Mark: m Diameter of Vanes (vertical) m  
 Height of Cairn: m Diameter of Cairn: m

Length of Mast: m (approximate if not piled)  
 5. A set in conc/rock has been placed/rd m. bearing °M from Trig. Mast/pillar  
 6. A set in conc/soil has been placed fd m. bearing °M from Trig. Mast/pillar  
 7. A set in conc/soil has been placed fd m. bearing °M from Trig. Mast/pillar  
 8. A set in conc/rock has been placed/rd m. bearing °M from Trig. Mast/pillar

9. Connection to m. bearing °M  
 10. Connection to m. bearing °M  
 11. Connection to m. bearing °M  
 12. Connection to m. bearing °M  
 13. Diff. Ht. is m. above below  
 14. Diff. Ht. is m. above below  
 15. Diff. Ht. is m. above below  
 16. Diff. Ht. is m. above below

Prepared by: L.M HAYES. Checked: 31/5/75  
 Date Record of Station

STATION COCKATOON HILL TS 1523

Current Occupant:

Address:

Owners Name:


Address:

Access 14-7-1975  
CONVENTIONAL VEHICLE CAN BE USED.

Not to Scale

Station Diagram

North

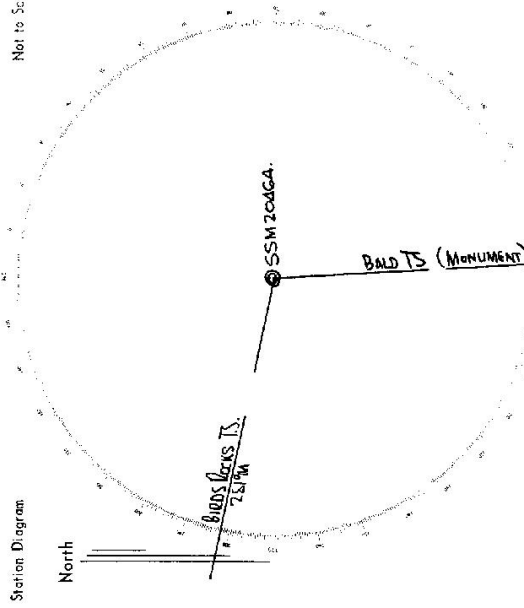

List of Observed Directions:-

Standpoint: SSM 2046A		Standpoint:	
Station	Direction	Station	Direction
BALD PULM. TS	S55° 55' 00"		
BIBBS RECKS TS	N04° 28' 17.2"		

