

GEODETTIC SURVEY OF N.S.W.

CENTRAL MAPPING AUTHORITY

GEODETTIC STATION RECONNAISSANCE and MAINTENANCE REPORT

Description:

1. Cleared by lanes bearing *NOT CLEARED. SURROUNDING BIRCH & PINE TREES*. Note: Cross out word or words which do not apply
2. ~~Mast & Vanes have been painted white & black respectively.~~
3. The station/pillar was unpiled/hot unpiled/constructed on *19* dimensions now being: Description of mark *should be explicit, e.g., S/Steel Pillar Plate, Steel plug, Brass plug, Bolt, G.I. Pipe*
- Height of mark *above below* m. Mark is *above below* m. G.L.
- Height of Top Vanes to Top Mark/Pillar plate *1.5* m. Diameter of Vanes (vertical) *1.5* m.
- Height of Cairn *1.5* m. Diameter of Cairn *1* m. Name Plate found/not found/blaced.
- Length of Mast *2.5* m. (approximate if not unpiled)
4. A *set in conc/rock has been placed/found, bearing 0° M from Mast/Plug/Pillar*
5. A *set in conc/rock has been placed/found, bearing 0° M from Mast/Plug/Pillar*
6. A *set in conc/rock has been placed/found, bearing 0° M from Mast/Plug/Pillar*
7. A *set in conc/rock has been placed/found, bearing 0° M from Mast/Plug/Pillar*
8. Action required:

STANDPOINT:

Mark	Direction	Horiz. Distance	Height Difference	Mark	Direction	Horiz. Distance	Height Difference
			above standpt				above standpt
			below standpt				below standpt
			above standpt				above standpt
			below standpt				below standpt
			above standpt				above standpt
			below standpt				below standpt
			above standpt				above standpt
			below standpt				below standpt

Prepared by: *AKM*

Checked:

Noted on U.T.M. Card

Checked

STATION: *COHEN (ACT)* No.: *1530*

MAP SHEET SCALE 1:250 000 *CANBERRA*

INSPECTED BY: *W MILLER* DATE: *12.5.78*

AUTHORITY: *CMA* FIELD BOOK:

Sr. 2733-2 D. West, Government Printer

GS 24

STATION **COHEN (ACT) TS 1530**

Owner's Name: **KOMEN FOREST KT** Current Occupant:



Address: **OFF SUTTON ROAD** Address:

NEAR QUEAN BEYAN Phone:

Phone:

ACCESS

Access Report of **12.5.78** was found suitable/unsuitable.

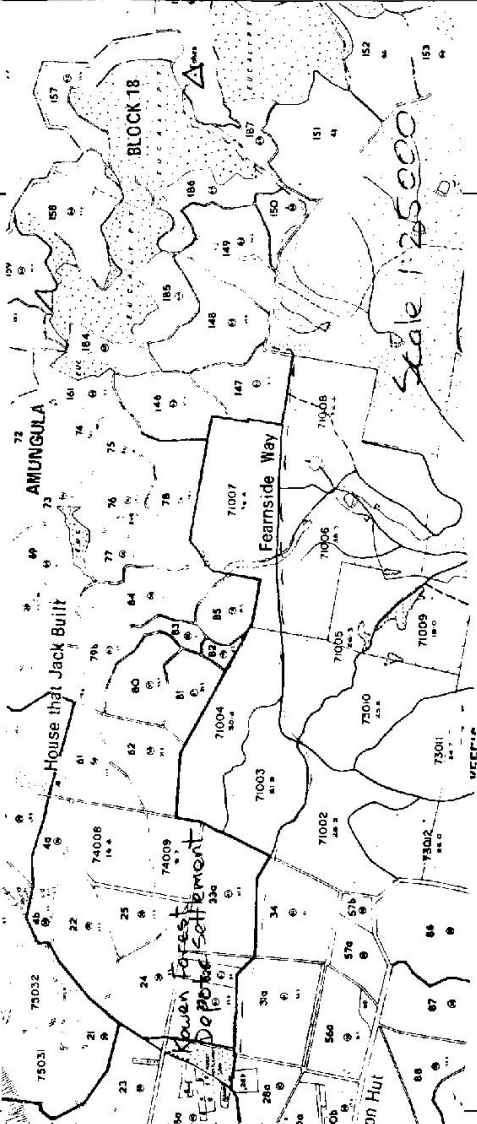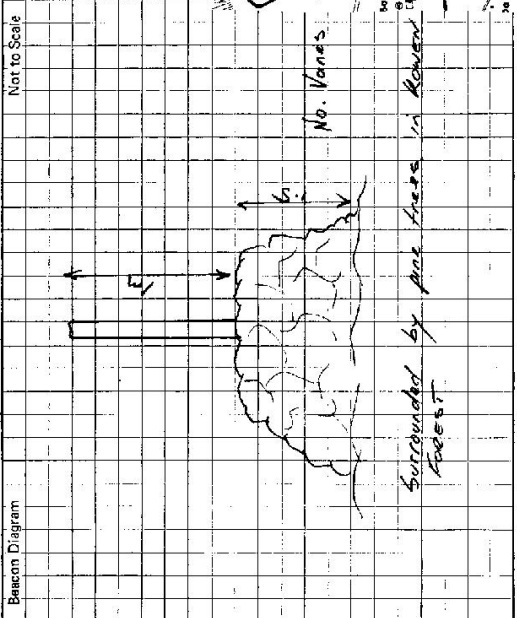

This section to be completed by officer constructing pillar.

Original station mark found/not found.

Description of mark:

Original beacon found/not found.

Description of beacon:

Height Top of Vanes to Top Mark.....m.

Height of mark.....m. above G.L. below

Diameter of Vanes.....m. Height of Cairn.....m.

Original Beacon has/has not been destroyed by me.

Date	Record of Station
12.5.78	Visited surrounded by pine trees - bad condition