

CENTRAL MAPPING AUTHORITY

GEODETIC SURVEY OF N.S.W.

GEODETIC STATION RECONNAISSANCE and MAINTENANCE REPORT


STATION: **COLLS G.S.** No.: **1543**

MAP SHEET SCALE 1:250 000 **NARROMINE**

INSPECTED BY: **R. COOK** DATE: **SEP 1978**

AUTHORITY: **C.M.A.** FIELD BOOK:

- Description:
- Cleared by lanes bearing..... *Note: Cross out word or words which do not apply*..... from Trig. Mast
  - Mast & Vanes have been painted white & black respectively.
  - The station/pillar was ~~erected~~ not unplied/constructed on.....19....., dimensions now being: Description of mark..... should be explicit. e.g., S/Steel Pillar Plate, Steel plug, Brass plug, Bolt, G.I. Pipe  
Height of mark.....m. <sup>above</sup> rock/concrete; Mark is.....m. <sup>above</sup> G.L.
  - Height of Top Vanes to Top Mark/Pillar plate .....m. Diameter of Vanes (vertical).....m.
  - Height of Cairn.....m. Diameter of Cairn.....m. Name Plate found/not found/placed.
  - Length of Mast.....m. (approximate if not unplied)
  - A.....set in conc/rock has been placed/found, bearing.....° M from Mast/Plug/Pillar
  - A.....set in conc/rock has been placed/found, bearing.....° M from Mast/Plug/Pillar
  - A.....set in conc/rock has been placed/found, bearing.....° M from Mast/Plug/Pillar
  - A.....set in conc/rock has been placed/found, bearing.....° M from Mast/Plug/Pillar
  - Action required: **CANN ONLY. EXTENSIVE CLEANING NEEDED. SWITCHES FOR PILLAR.....**

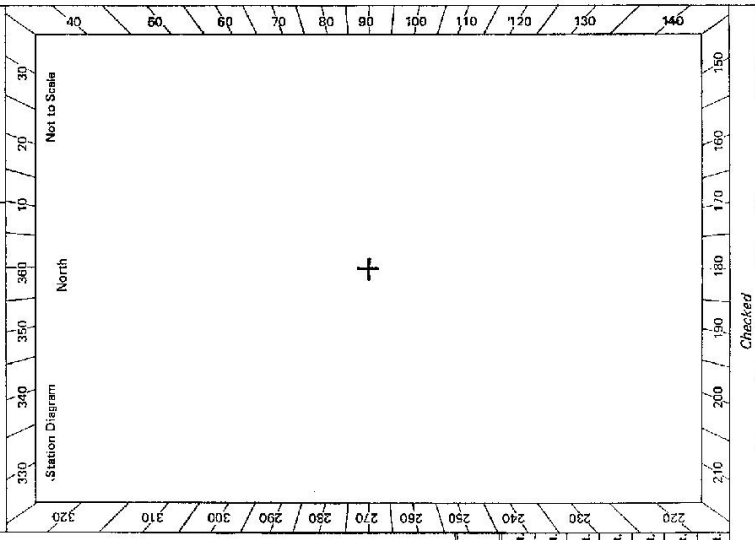

STANDPOINT:


Mark	Direction	Horiz. Distance	Height Difference	Mark	Direction	Horiz. Distance	Height Difference
			above standpt.				above standpt.
			below standpt.				below standpt.
			above standpt.				above standpt.
			below standpt.				below standpt.
Prepared by: **R. COOK** Checked:

Noted on U.I.M. Card

Sr 2735-2 D. West, Government Printer

STATION COLLS G. S. TS 1543

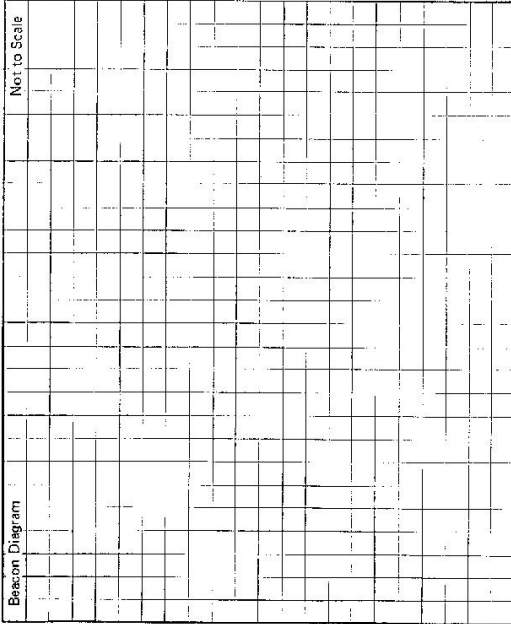

Owner's Name: .....  
 Address: .....  
 Phone: .....  
 Current Occupant: .....  
 Address: .....  
 Phone: .....

Phone: **sept - 1978**  
 ACCESS  
 Access Report of ...../19..... was found suitable/unsuitable.

**Drive to (access) found on the F field 1:50,000 sheet.**

This section to be completed by officer constructing pillar.

Original station mark found/not found.

Description of mark: .....

Original beacon found/not found.

Description of beacon: .....

Height Top of Vanes to Top Mark .....m.

Height of mark .....m above rock/cont. ....m. above G.L.  
 below

Diameter of Vanes .....m.

Height of Cairn .....m.

Original Beacon has/has not been destroyed by me.

Date	Record of Station
SEPT. 1978	STATION VISITED IN CONNECTION WITH FIELD COMPLETION.