

Integral Survey of N.S.W.

Department of Lands

RECONNAISSANCE and MAINTENANCE REPORT 1561

STATION CONDELL PARK Ph: BANKSTOWN TS 1561

This Trig. Station has been:-

Note: Cross out word or words which do not apply

1. Completely cleared to permit 360° vision to surrounding Trigs.
2. Cleared by lanes bearing from Trig. Mast

Co: CUMBERLAND  
 Map Sheet: REGENTS PARK No: 0045  
 Inspected by: Date:  
 Authority: Field Book:  
 Beacon Diagram Not to Scale

To	B.L. (metres)	Direction or Vert. Angle V	Variance V	Observer	Date	Dist. in metres at M.S.L.	A. H. D.	Inst.	Observer	Date
CONDELL PARK					19-7				2.45	
NAVIGATION LIGHT									1.65	
R 178 partially obscured and situated						0.00	0.62		0.62	
TRIG. STATION						0.00	0.00		0.00	
R 31 partially obscured						0.00	0.00		0.00	
TRIG. STATION						0.00	0.00		0.00	
TRIG. STATION						0.00	0.00		0.00	

All directions Connected to centre  
 G 38  
 13. Diff. Ht. is m. below  
 14. Diff. Ht. is m. above  
 15. Diff. Ht. is m. below  
 16. Diff. Ht. is m. above  
 Prepared by: Checked:  
 SEE NEAR OF CARD FOR REMARKS  
 Ab. Vert's corrected amount to ground

Date	Record of Station



25-103

Department of Lands  
 Integration of N.S.W.  
 RECONNAISSANCE and MAINTENANCE REPORT  
 STATION Condell Park (P) TS. 1561  
 Co: CUMBERLAND Ph: BANKSTOWN  
 Map Sheet: REGENTS PARK No: 0045  
 Inspected by: L.M Hayes Date: 6th June 1976  
 Authority Dept Lands Field Book: GBL104  
 Not to Scale  
 1:92  
 0.575  
 1.225  
 0.425  
 1.35  
 STEEL  
 PLATEFORM  
 Date: 16-2-72 Record of Station  
 Per previous visit (A new work observation) (L Hayes)

Note: Cross out words or words which do not apply

This Trig. Station has been:-

1. Completely cleared to permit 360° vision to surrounding Trigs.
2. Cleared by lanes bearing \_\_\_\_\_ from Trig. Mast
3. Trig. Mast & Vanes have been painted white & black respectively.
4. The Trig. was unpiled/not unpiled, dimensions now being:
  - Description of mark: steel pillar should be explicit, e.g. Steel plug, Brass plug, Bolt, Concrete Pillar
  - Height of mark: 1.35 m above steel platform below rock/concrete G.L.
  - Height of Top Vanes to ~~top~~ Top pillar plate 2.435 m Diameter of Vanes (vertical) 0.575 m.
  - Height of Cairn: \_\_\_\_\_ m. Diameter of Cairn: \_\_\_\_\_ m.
  - Length of Mast: 1.82 m. (approximate if not unpiled)
5. A. \_\_\_\_\_ set in conc/rock has been placed/fd \_\_\_\_\_ m. bearing \_\_\_\_\_ °M from Trig. Mast/pillar
6. A. \_\_\_\_\_ set in conc/soil has been placed/fd \_\_\_\_\_ m. bearing \_\_\_\_\_ °M from Trig. Mast/pillar
7. A. \_\_\_\_\_ set in conc/soil has been placed/fd \_\_\_\_\_ m. bearing \_\_\_\_\_ °M from Trig. Mast/pillar
8. A. \_\_\_\_\_ set in conc/rock has been placed/fd \_\_\_\_\_ m. bearing \_\_\_\_\_ °M from Trig. Mast/pillar

9. Connection \_\_\_\_\_ to \_\_\_\_\_ m. bearing \_\_\_\_\_ °M
10. Connection \_\_\_\_\_ to \_\_\_\_\_ m. bearing \_\_\_\_\_ °M
11. Connection \_\_\_\_\_ to \_\_\_\_\_ m. bearing \_\_\_\_\_ °M
12. Connection \_\_\_\_\_ to \_\_\_\_\_ m. bearing \_\_\_\_\_ °M
13. Diff. Ht. \_\_\_\_\_ is \_\_\_\_\_ m. above below
14. Diff. Ht. \_\_\_\_\_ is \_\_\_\_\_ m. above below
15. Diff. Ht. \_\_\_\_\_ is \_\_\_\_\_ m. above below
16. Diff. Ht. \_\_\_\_\_ is \_\_\_\_\_ m. above below


Prepared by: L.M Hayes 7-5-76 Checked: [Signature]

STATION Condell Ark TS. 1561

Owners Name: M.W.S. + DB  
 Current Occupant: .....

Address: .....

6th June 1976  
 Access Conventional Vehicle B-3  
 UBD Map 90 Reference ~~11~~  
 Access off Manahan St.  
 Waterboard Key necessary for gate & ladder.

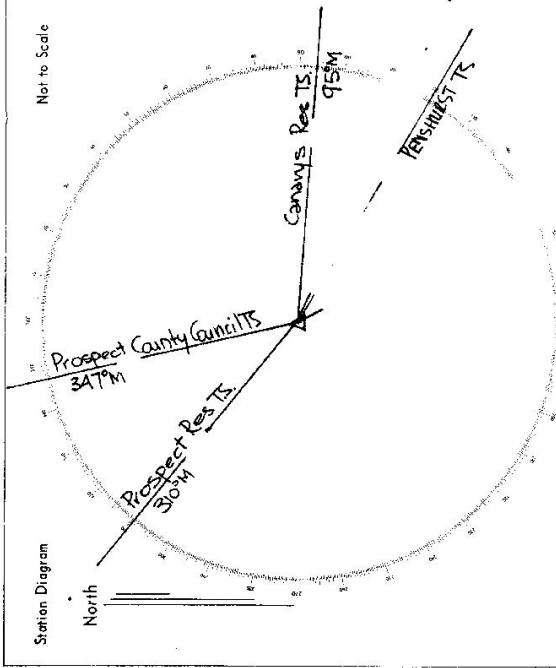

List of Observed Directions:-

Station	Direction	Station	Direction
Standpoint: steel pillar	Standpoint: steel pillar	17/2/77	
Prospect Res. TS	359° EA / 60°	Canarys TS	350° EA / 60°
Prospect County Council TS	37° W / 012°	Pensilvest TS	28° OS / 486°
Canarys Res. TS	413° ON / 002°		

Station	Direction	Station	Direction