

CENTRAL MAPPING AUTHORITY

GEODETIC SURVEY OF M.S.W.

GEODETIC STATION RECONNAISSANCE and MAINTENANCE REPORT

STATION: CONROY No.: 1573

MAP SHEET SCALE 1:250 000 CARGELLIGO

INSPECTED BY: C. C. HANNA DATE: 15/5/79

AUTHORITY: C.M.A. FIELD BOOK:

- Description:
1. Cleared by lanes bearing..... *Note: Cross out word or words which do not apply*..... from Trig. Mast
 2. Mast & Vanes have been painted white & black respectively.
 3. The station/pillar was unpiled/not unpiled/constructed on..... 19..... dimensions now being:
Description of mark..... should be explicit, e.g., S/Steel Pillar Plate, Steel plug, Brass plug, Bolt, G.I. Pipe
Height of mark..... m. above rock/concrete; Mark is..... m. above G.L.
 - Height of Top Vanes to Top Mark/Pillar plate..... m. Diameter of Vanes (vertical)..... m.
 - Height of Cairn..... m. Diameter of Cairn..... m. Name Plate found/not found/placed.
 - Length of Mast..... m. (approximate if not unpiled)
 4. A..... set in conc/rock has been placed/found, bearing..... ° M from Mast/Plug/Pillar
 5. A..... set in conc/rock has been placed/found, bearing..... ° M from Mast/Plug/Pillar
 6. A..... set in conc/rock has been placed/found, bearing..... ° M from Mast/Plug/Pillar
 7. A..... set in conc/rock has been placed/found, bearing..... ° M from Mast/Plug/Pillar
 8. Action required:.....

STANDPOINT:


Mark	Direction	Horiz. Distance	Height Difference	Mark	Direction	Horiz. Distance	Height Difference
			above standpt				above standpt
			below standpt				below standpt
			above standpt				above standpt
			below standpt				below standpt
Prepared by: C. C. Hanna 15/5/79

Checked: J. P. [Signature] 15.3.85

Noted on U.T.M. Card

St 2733-1

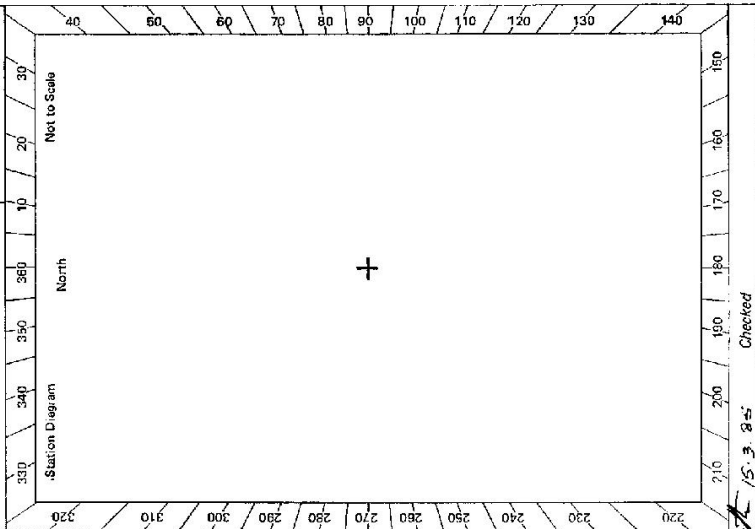

GS 24

STATION CONROY	TS 1573	Owner's Name: Address: Phone: Current Occupant: Address: Phone: ACCESS See Rankine Springs 8130-S Access Report of 15.2.1977 was found suitable/unsuitable.
Not to Scale <p style="text-align: center;">Distances are in Kilometres Diagram not to scale</p>		O-O Erigolia towards Yenda 11-6 R.H. turn up property track 12-9 Gate. Park truck & walk up slight hill to trig Cairn found, mast & vanes in disrepair 5 minute walk to trig Light clearing required
This section to be completed by officer constructing pillar. Original station mark found/not found.		Description of mark: Original beacon found/not found.
Description of beacon: Height Top of Vanes to Top Markm. Height of markm. above rock/conem. below G.L. Diameter of Vanesm. Height of Cairnm. Original Beacon has/has not been destroyed by me.		Date Record of Station

St 2733-2 D. West, Government Printer