

CENTRAL MAPPING AU THURKILL

Trigonometrical Survey of N.S.W.

COCKSHIRE (NEW)

Department of Lands

RECONNAISSANCE and MAINTENANCE REPORT

STATION

COCKABYNE NEW TS 1583

This Trig. Station has been:-

Note: Cross out word or words which do not apply

1. Completely cleared to permit 360° vision to surrounding Trigs.
2. Cleared by lanes bearing..... from Trig. Mast
3. Trig. Mast & Vanes have been painted white & black respectively.
4. The Trig. was unpiled/not unpiled, dimensions now being:

Description of mark..... should be explicit, e.g. Steel plug, Brass plug, Bolt, G.L. Pipe

Height of mark..... m above rock/concrete..... m below G.L.

Height of Top Vanes to Top Mark..... m. Diameter of Vanes (vertical)..... m.

Height of Cairn..... m. Diameter of Cairn..... m.

Length of Mast..... m. (approximate if not unpiled)

5. A..... set in conc./rock has been placed..... m bearing.....°M from Trig. Mast
6. A..... set in conc./soil has been placed..... m bearing.....°M from Trig. Mast
7. A..... set in conc./soil has been placed..... m bearing.....°M from Trig. Mast
8. A..... set in conc./rock has been placed..... m bearing.....°M from Trig. Mast

NOT APPLICABLE

9. Connection..... to..... m. bearing.....°M
10. Connection..... to..... m. bearing.....°M
11. Connection..... to..... m. bearing.....°M
12. Connection..... to..... m. bearing.....°M
13. Diff. Ht. is..... m. above below
14. Diff. Ht. is..... m. above below
15. Diff. Ht. is..... m. above below
16. Diff. Ht. is..... m. above below

Prepared by: Checked: Noted on U.T.M. Card

Co: Hume
 Map Sheet: Holbrook
 Inspected by: G. Hanna
 Authority:
 Beacon Diagram
 No: 8326-N
 Date: 24/9/76
 Field Book:
 Not to Scale

Date	Record of Station

Checked


STATION **COOKABRYNE**
COOKABRYNE NEW TS 1583

Owners Name.....
 Current Occupant.....
 Address.....
 Address.....

Not to Scale

Station Diagram

North

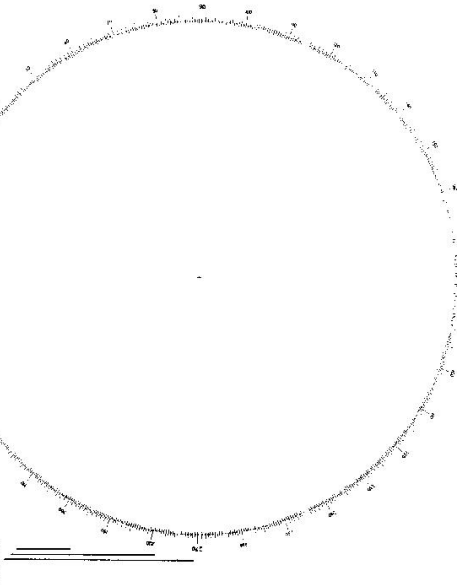

List of Observed Directions:-

Standpoint:

Standpoint:

Station	Direction	Station	Direction

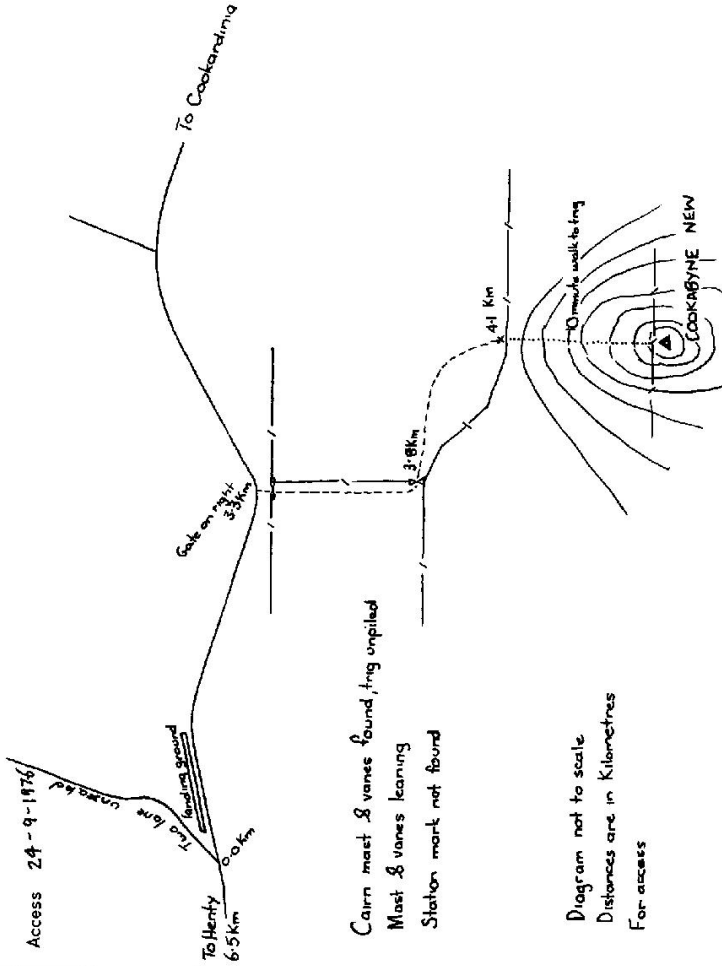


Diagram not to scale
 Distances are in Kilometres
 For access