

CENTRAL MAPPING AUTHORITY

GEODETIC SURVEY OF NSW
 GEODETIC STATION RECONNAISSANCE and MAINTENANCE REPORT

Description:

1. Cleared by fence bearing ~~110°~~ ^{360°} ~~25.215°~~ ^{steep slope} from Trig. Mast
 Note: Cross out word or words which do not apply
2. Mast & Vanes have been painted white & black respectively. Reason in good condition. (Could be piloned)
3. The station/pillar was ~~unpiled~~ not unpiled/reconstructed on 19..... dimensions now being:
 Description of mark..... should be explicit, e.g., S/Steel Pillar Plate, Steel plug, Brass plug, Bolt, G.I. Pipe
 Height of mark.....m. ^{above} ~~below~~ rock/concrete; Mark is.....m. ^{above} ~~below~~ G.L.
 Height of Top Vanes to Top Mark/Pillar plate 2.7m. Diameter of Vanes (vertical) 1.01m.
 Height of Cairn 1.6m. Diameter of Cairn 2.8m. Name Plate found/not found/placed.
 Length of Mast.....m. (approximate if not unpiled)
4. A..... set in conc/rock has been placed/found, bearing.....°M from Mast/Plug/Pillar
5. A..... set in conc/rock has been placed/found, bearing.....°M from Mast/Plug/Pillar
6. A..... set in conc/rock has been placed/found, bearing.....°M from Mast/Plug/Pillar
7. A..... set in conc/rock has been placed/found, bearing.....°M from Mast/Plug/Pillar
8. Action required:..... TOWER RANGING
 1:25,000

STANDPOINT:

Mark	Direction	Horiz. Distance	Height Difference	Mark	Direction	Horiz. Distance	Height Difference
			above standpt.				above standpt.
			below				below
			above standpt.				above standpt.
			below				below
Prepared by: *[Signature]*

Checked: *[Signature]*

SR 2733-1

STATION: COOKBUNDJOON No.: 1587
 MAP SHEET SCALE 1:250,000 Goulburn
 INSPECTED BY: A. Sivertsen DATE: 12-10-78
 AUTHORITY: CMA FIELD BOOK: 1642

Station Diagram

Not to Scale

Checked

CENTRAL MAPPING AUTHORITY

GEODETTIC SURVEY OF N.S.W.

GEODETTIC STATION RECONNAISSANCE and MAINTENANCE REPORT

Description:

1. Cleared by lanes bearing 192.4 ^{above} 192.4 ^{below} from Trig. Mast

2. Mast & Vanes have been painted white & black respectively, x

3. The station/pillar was ~~replaced~~ ^{replaced} /not unpiled/~~concreted~~ ^{concreted} on 2.1m 10p ^{above} 192.4 ^{below}, dimensions now being: 1.5 ^{above} 1.5 ^{below}

Description of mark 1.5 ^{above} 1.5 ^{below} should be explicit, e.g., S/Steel Pillar Plate, Steel plug, Brass plug, Bolt, G.I. Pipe
 Height of mark 1.5 ^{above} 1.5 ^{below} m. above rock/concrete; Mark is 1.5 ^{above} 1.5 ^{below} m. above G.L.

Height of Top Vanes to Top Mark/Pillar plate 2.1m 10p ^{above} 192.4 ^{below} m. Diameter of Vanes (vertical) 1.1 ^{above} 1.1 ^{below} m.

Height of Cairn 1.5 ^{above} 1.5 ^{below} m. Diameter of Cairn 1.5 ^{above} 1.5 ^{below} m. Butt Name Plate ~~found~~/not found/~~placed~~.

Length of Mast 4.6 ^{above} 4.6 ^{below} m. (approximate if not unpiled)

4. A. 4.6 ^{above} 4.6 ^{below} set in conc/rock has been placed/found, bearing 192.4 ^{above} 192.4 ^{below} °M from Mast/Plug/Pillar

5. A. 4.6 ^{above} 4.6 ^{below} set in conc/rock has been placed/found, bearing 192.4 ^{above} 192.4 ^{below} °M from Mast/Plug/Pillar

6. A. 4.6 ^{above} 4.6 ^{below} set in conc/rock has been placed/found, bearing 192.4 ^{above} 192.4 ^{below} °M from Mast/Plug/Pillar

7. A. 4.6 ^{above} 4.6 ^{below} set in conc/rock has been placed/found, bearing 192.4 ^{above} 192.4 ^{below} °M from Mast/Plug/Pillar

8. Action required: None

STANDPOINT:

STANDPOINT:

Mark	Direction	Horiz. Distance	Height Difference	Mark	Direction	Horiz. Distance	Height Difference
			above standpt.				above standpt.
			below				below
			above standpt.				above standpt.
			below				below
Prepared by: D. J. KING

Checked: D.J.K.

Checked: D.J.K.

STATION: Cook Bundoon Creek S.M. No: 1587
 MAP SHEETS: SCALE 1:100 000
 SCALE: 1:250 000 Woolburran
 INSPECTED BY: D. J. KING DATE: 25 May 1984
 AUTHORITY: C.M.A. FIELD BOOK: 154

Station Diagram
 North
 15 M Not to Scale
 ESTIMATE of LINE TO CLEAR
 LANSING and CLEARING GRIDS
 2 days with OTHER STAKES


6: 2733-3 D. West. Government Printer

STATION **COOKBOUNDOON GEODETIC STATION 1587**

Owner's Name: **19 19774 Vincent Moran**
 Address: **166 Marlborough St. B.O.**
 Phone: **0482 736665**
 Current Occupant: **Mrs. P. O. BARKER**
 Address: **166 Marlborough St. B.O.**
 Phone: **0482 736665**

Access Report of **10/10/19** was found suitable/acceptable. With addition of **20.44** kms.

FEATURE
K644
 0.00 **COULBURN P.O. TAKE HIGHWAY NORTH.**
 1.20 **TURN L FOLLOWING PARALLEL SIGNS.**
 4.00 **PLY CROSSING.**
 7.55 **TURN R UP LANEWAY AT END OF PAGES OPP TOWN/SHIRE SIGN.**
 7.80 **HOUSE CALL IN (MR RICHARD GOODMAN) THEN CONTINUE AROUND TO L.H.S. OF DRIVE. THROUGH GATE AND DOWN LANEWAY STRAIGHT AHEAD.**
 8.40 **LINE.**
 8.70 **TRUCK ON R AND FOLLOW FENCE.**
 9.20 **CROSS PADDOCK TOWARDS UNITES.**
 9.70 **THROUGH WIRE GATE AND FOLLOW FENCE TO L.**
 10.00 **PASS GATE ON L.**
 10.35 **THROUGH GATE AND FOLLOW FENCE TO LEFT. HEAD TOWARDS SIDE AND TAKE UP NINEEL TRACKS ACROSS SPUR.**
 10.80 **TURN L ONTO ROAD TRACK.**
 11.70 **X-ROADS. TO STRAIGHT AHEAD ALONG RIDGE GATE AND PASS TRACK ON L.**
 12.20 **TURN R FORK.**
 20.2 & 20.7 **GATES.**
 20.44 **BLAZED TRAIL ON YOUR R.H.S. TURN RIGHT ONTO TRAIL.**
 20.54 **COOKBOUNDOON - GEODETIC STATION.**

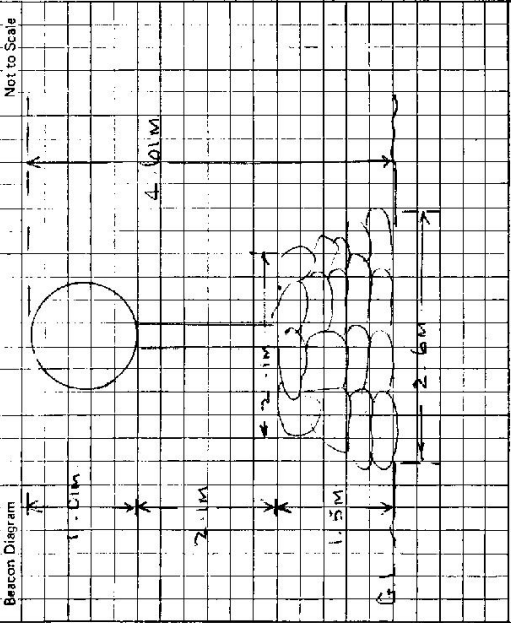

This section to be completed by officer constructing pillar.
 Original station mark found/not found.
 Description of mark:
 Original beacon found/not found.
 Description of beacon:
 Height Top of Vanes to Top Markm.
 Height of markm. above below G.L.
 Diameter of Vanesm. Height of Cairnm.
 Original Beacon has/has not been destroyed by me.

Date	Record of Station