



1590 STATION COOLABAH TS 1590

Owners Name.....
 Current Occupant.....
 Address.....
 Address.....

26-8-1981

Access SEE OWNER OF "KILLAWARRA" FOR DIRECTIONS

- 0.0 KM COOLABAH POLICE STN
- 0.02 KM EAST TAKE BREWARRINA ROAD
- 5.0 KM TURN RIGHT TOWARDS "KILLAWARRA"
- 13.0 KM PASS "KILLAWARRA" HEADS ON LEFT, CONTINUE ON UNTIL GRID.
- TURN LEFT AND FOLLOW TRACK BESIDE FENCE.
- 13.6 KM SHEEPYARDS ON RIGHT, CONTINUE 100M & FOLLOW ROUGH TRACK TO TRIC.

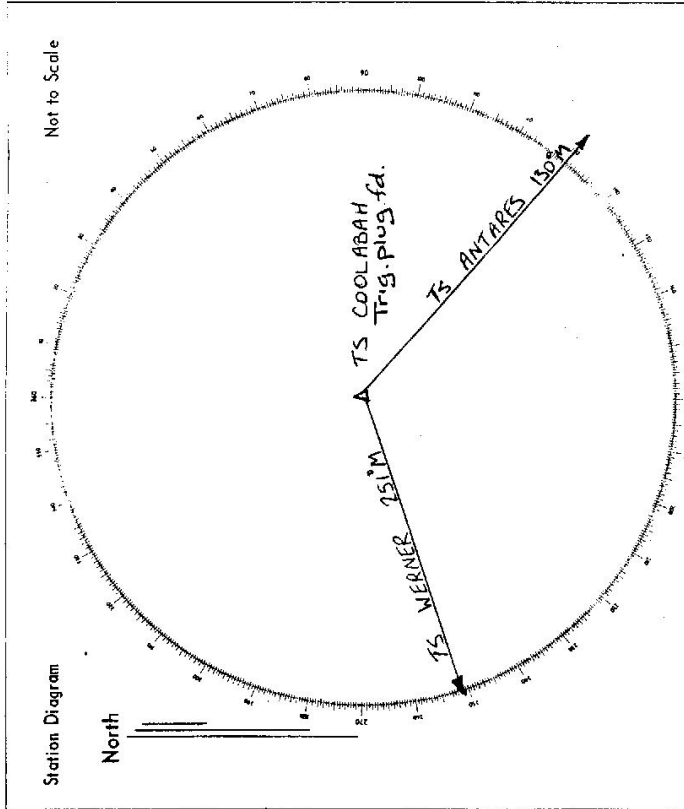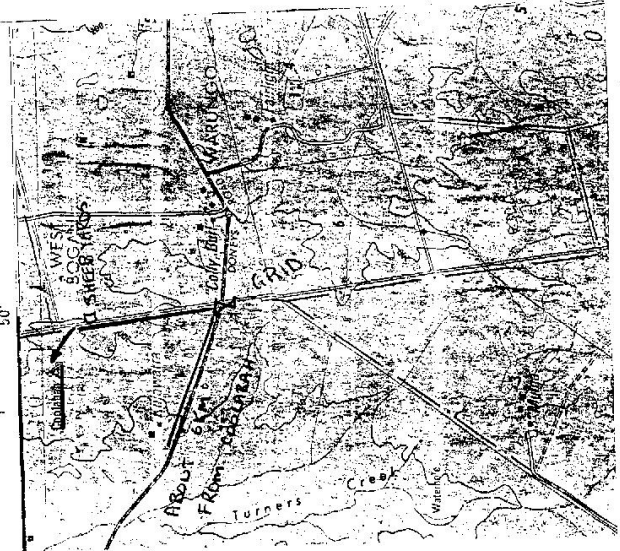

List of Observed Directions:- F01 176975
 Standpoint: COOLABAH TRIG PLUG Standpoint:

Station	Direction	Station	Direction
TS WERNER	251 00 00		
TS ANTARES (T)	130 23 05		