

CENTRAL MAPPING AUTHORITY  
Department of Lands

Trigonometrical Survey of N.S.W.

RECONNAISSANCE and MAINTENANCE REPORT

STATION COOLAMATONG G.S. TS 1594

Co:   
 Map Sheet: BERRIDALE No: 8625   
 Inspected by: A. WOODRUFF Date: 20/1/77   
 Authority: C.M.A. Field Book: 153D   
 Beacon Diagram Not to Scale

This Trig. Station has been:- Note: Cross out word or words which do not apply

1. Completely cleared to permit 360° vision to surrounding Trig.
2. Cleared by lines bearing 60° - 80° M. 215° - 225° M. from Trig. Mast
3. Trig. Mast & Vanes have been painted white & black respectively.
4. The Trig. was unpiled/not unpiled, dimensions now being:


Description of mark..... should be explicit, e.g. Steel plug, Brass plug, Bolt, G.I. Pipe  
 Height of mark..... m above rock/concrete ..... m above G.L.  
 Height of Top Vanes to Top Mark..... m. Diameter of Vanes (vertical) 0.750 m.  
 Height of Cairn 2.0 m. Diameter of Cairn 1.75 m.  
 Length of Mast 3.87 m. (approximate if not unpiled)

5. A DRILL HOLE set in conc/rock has been placed 5.52 m. bearing 50° M from Trig. Mast
6. A..... set in conc/soil has been placed..... m. bearing.....° M from Trig. Mast
7. A..... set in conc/soil has been placed..... m. bearing.....° M from Trig. Mast
8. A..... set in conc/rock has been placed..... m. bearing.....° M from Trig. Mast

9. Connection..... to..... m. bearing.....° M
10. Connection..... to..... m. bearing.....° M
11. Connection..... to..... m. bearing.....° M
12. Connection..... to..... m. bearing.....° M

13. Diff. Ht. DRILL HOLE PLACED is 4.33 m. above Bottom of Vanes, Coolamalong G.S.
14. Diff. Ht. is..... m. above.....
15. Diff. Ht. is..... m. above.....
16. Diff. Ht. is..... m. above.....


Prepared by: Alan Woodruff Checked: W. Hill Noted on U.T.M. Card

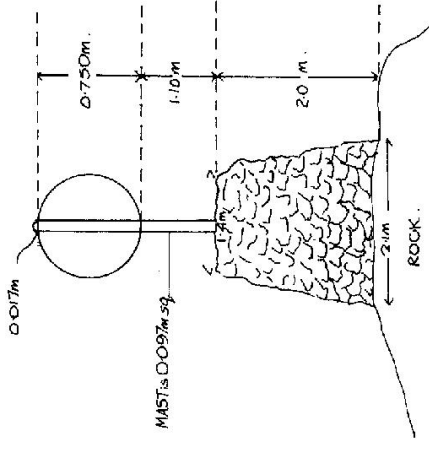

Date Record of Station

Checked Alan Woodruff 27/3/79.

	STATION	COOLAMATONG GS. TS 1594
Owners Name.....	Current Occupant.....	
Address.....	Address.....	
Access 20-1-1977		
MILEAGE	DESCRIPTION	
0.0 Kms.	From Bendale take sealed road towards Dalgety	
5.4 Kms.	Turn Right through gate and follow track to property	
9.0 Kms.	At property call in and see owner.	
9.1 Kms.	Pass through gate	
9.3 Kms.	Turn left from track and make own way in vehicle to Trig.	
9.8 Kms.	Park vehicle at rocks close to Trig.	

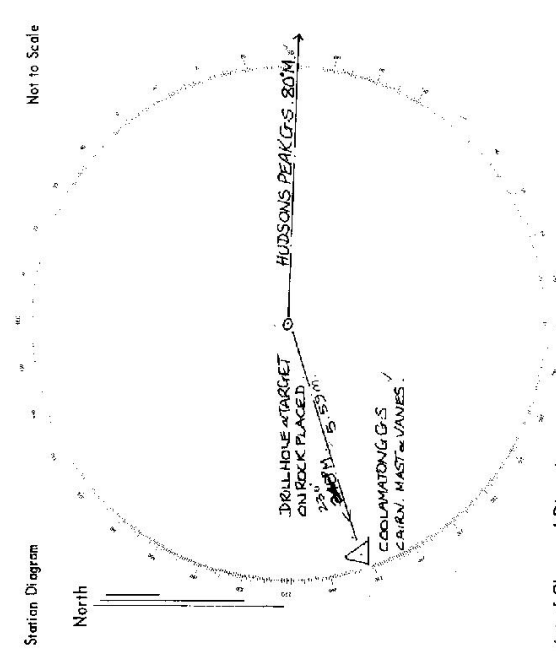

List of Observed Directions:-

Standpoint: Drill hole in Rock Placed; Standpoint:

Station	Direction	Station	Direction
HUDSONS PEAK	003° 00' 00"		
Coolamalong G.S. LHS	148° 49'		
Mask	RHS		
	150° 13'		
Station	Direction	Station	Direction