

GEODETIC SURVEY OF N.S.W.

CENTRAL MAPPING AUTHORITY

GEODETIC STATION RECONNAISSANCE and MAINTENANCE REPORT

STATION: SMA 0106 No.: 16

Description:

1. Cleared by James bearing.....
 Note: Cross out word or words which do not apply

2. ~~Mast & Vanes have been painted white & black respectively.~~

3. The station/pillar was unpiled/hot unpiled/constructed on..... 19....., dimensions now being:

Description of mark..... should be explicit, e.g., S/Steel Pillar Plate, Steel plug, Brass plug, Bolt, G.I. Pipe

Height of mark.....m. ^{above} _{below} rock/concrete; Mark is.....m. ^{above} _{below} G.L.

Height of Top Vanes to Top Mark/Pillar plate.....m. Diameter of Vanes (vertical).....m.

Height of Cairn.....m. Diameter of Cairn.....m. Name Plate found/not found/placed.

Length of Mast.....m. (approximate if not unpiled)


4. A..... set in conc/rock has been placed/found, bearing.....°M from Mast/Plug/Pillar

5. A..... set in conc/rock has been placed/found, bearing.....°M from Mast/Plug/Pillar

6. A..... set in conc/rock has been placed/found, bearing.....°M from Mast/Plug/Pillar

7. A..... set in conc/rock has been placed/found, bearing.....°M from Mast/Plug/Pillar

8. Action required: ~~Needs painting black and white~~

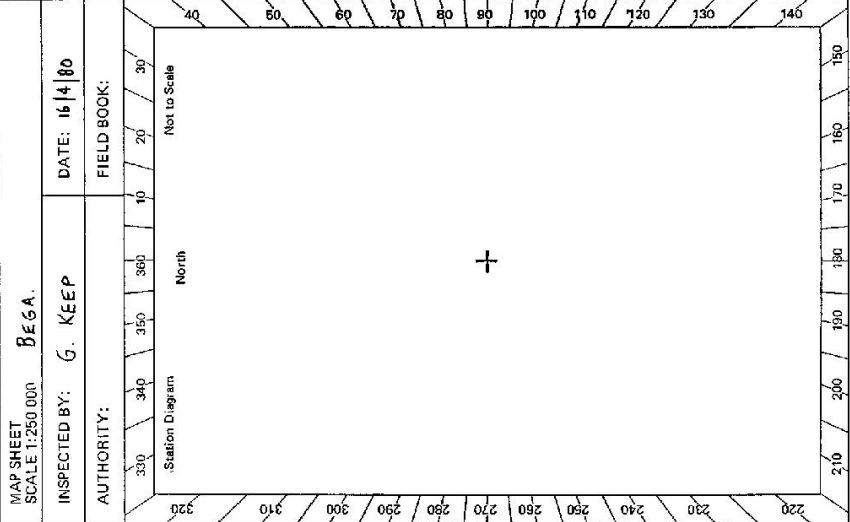

STANDPOINT:					
Mark	Direction	Horiz. Distance	Height Difference	Mark	Direction
			above standpt.		above standpt.
			below standpt.		below standpt.
			above standpt.		above standpt.
			below standpt.		below standpt.
Prepared by: G. Keep 24/7/80

Checked: Noted on U.T.M. Card

Checked: G. Keep 24/7/80

ISS

et. 2735-2 D. West, Government Printer Beacon Diagram	Not to Scale 	STATION SMA 0106 TS 16	Owner's Name: Address: Phone: Current Occupant: Address: Phone: ACCESS Access Report of/19.....was found suitable/unsuitable. Quadrapod seen from road, standing upright and appeared in good condition. Suitable for geodetic station.
This section to be completed by officer constructing pillar. Original station mark found/not found. Description of mark: Original beacon found/not found. Description of beacon: Height Top of Vanes to Top Markm. Height of markm. above G.L. below rock/conc.m. below Diameter of Vanesm. Height of Cairnm. Original Beacon has/has not been destroyed by me.		Date Record of Station	