

CENTRAL MAPPING AUTHORITY
 GEODETIC SURVEY OF M.S.W.
 GEODETIC STATION RECONNAISSANCE and MAINTENANCE REPORT

STATION: CUNAWALE No: 1619
 MAP SHEET SCALE 1:250 000 WALLETT
 INSPECTED BY: K HADSON DATE: 27-2-81
 AUTHORITY: C.M.A. FIELD BOOK: C-73

- Description:
- Cleared by lanes bearing..... 36° 45' 00"..... from Trig. Mast
 Note: Cross out word or words which do not apply
 - Mast & Vanes have been painted white & black respectively.
 - The station/pillar was ~~used~~/not unplied/~~constructed~~ on..... 27-2-79..... dimensions now being:
 Description of mark: Brass Bolt..... should be explicit, e.g., S/Steel Pillar Plate, Steel plug, Brass plug, Bolt, G.I. Pipe
 Height of mark..... m. above rock/concrete; Mark is..... m. above G.L.
 Height of Top Vanes to Top Mark/Pillar plate..... 2.43..... m. Diameter of Vanes (vertical)..... 0.26..... m.
 Height of Calm..... m. Diameter of Calm..... m. Name Plate found/not found/placed.
 Length of Mast..... 2.43..... m. (approximate if not unplied)
 - A..... set in conc/rock has been placed/found, bearing..... ° M from Mast/Plug/Pillar
 - A..... set in conc/rock has been placed/found, bearing..... ° M from Mast/Plug/Pillar
 - A..... set in conc/rock has been placed/found, bearing..... ° M from Mast/Plug/Pillar
 - A..... set in conc/rock has been placed/found, bearing..... ° M from Mast/Plug/Pillar
 - Action required: Construction of Roof Top Pillar if possible

STANDPOINT:

| Mark | Direction | Horiz. Distance | Height Difference | Mark | Direction | Horiz. Distance | Height Difference |
|------|-----------|-----------------|-------------------|------|-----------|-----------------|-------------------|
| | | | above standpt. | | | | above standpt. |
| | | | below | | | | below |
| | | | above standpt. | | | | above standpt. |
| | | | below | | | | below |
Prepared by: KJ Hadson 4-3-81
 Checked: V. G. G. G. Noted on U.T.M. Card

SI 2733-2 D. West, Government Printer

| | |
|--|--|
| <p>STATION <u>COONAMBLE</u> TS-1619</p> <p>Owner's Name: <u>COONAMBLE SHIRE COUNCIL</u> Address: Phone:</p> <p>Current Occupant: Address: Phone:</p> <p>Access Report of <u>27.2.1981</u> was found suitable/unsuitable. <u>Tower is located in Yarran Street Coonamble</u></p> | <p>Beacon Diagram</p> <p>Not to Scale</p> <p>0.76</p> <p>0.10</p> <p>1.67</p> <p>Beacon wired to safety fence circular platters on top of concrete pillar</p> <p>Gate Platform</p> |
| <p>This section to be completed by officer constructing pillar.</p> <p>Original station mark found/not found.</p> <p>Description of mark:</p> <p>Original beacon found/not found.</p> <p>Description of beacon:</p> <p>Height Top of Vanes to Top Markm. above G.L. below</p> <p>Height of markm. above G.L. below</p> <p>Diameter of Vanesm. Height of Cairnm.</p> <p>Original Beacon has/has not been destroyed by me.</p> | |
| <p>Date</p> | <p>Record of Station</p> |

CARD No. 1 of 2 CARDS

LAND INFORMATION CENTRE

GEODETIC SURVEY OF A.S.W.

GEODETIC STATION RECONNAISSANCE and MAINTENANCE REPORT

Description:

1. Cleared by lanes bearing. PERMITS 360° VISION ✓ Note: Cross out word or words which do not apply
2. Mast & Vanes have been painted white & black respectively. ✓
3. The station/pillar was unpiled/~~renewed~~ reconstituted on 13.9 19.9 dimensions now being: Drill hole
Description of mark AND WINGS should be explicit, e.g. S/Steel Pillar Plate, Steel plug, Brass plug, Bolt, G.I. Pipe
- Height of mark Level ✓ above rock/concrete; Mark is ✓ above G.L.
- Height of Top Vanes to Concrete Platform 2.43 m. Diameter of Vanes (vertical) 0.76 m.
- Height of Cairn — m. Diameter of Cairn — m. Name Plate found/not found/missing.
- Length of Mast 2.43 m. (approximate if not supplied)
4. A Copper Nail set in conc/rock has been placed/found, bearing 30 M from Mast/plug/pillar Drill hole and wings
5. A G.I. Pipe set in conc/rock has been placed/found, bearing 118 M from Mast/plug/pillar Drill hole and wings
6. A — set in conc/rock has been placed/found, bearing — N from Mast/Plug/Pillar
7. A — set in conc/rock has been placed/found, bearing — M from Mast/Plug/Pillar

Action required:


STANDPOINT: Drill hole and wings 1 STANDPOINT: Copper Nail 2

| Mark | Direction | Horiz. Distance | Height Difference | Mark | Direction | Horiz. Distance | Height Difference |
|-------------|-----------|-----------------|-------------------|--------------------|-----------|-----------------|-------------------|
| AERIAL | 0 00 00 | ✓ | above standpt. | AERIAL | 0 00 00 | ✓ | above standpt. |
| Copper Nail | 185 35 06 | 22.358 | 24.764 | Drill hole & wings | 5 19 52 | 22.343 | 24.777 |
| G.I. Pipe | 287 02 59 | 26.874 | 24.585 | G.I. Pipe | 327 43 06 | 33.488 | 0.195 |
| | | | above standpt. | | | | above standpt. |
| | | | below standpt. | | | | below standpt. |
| | | | above standpt. | | | | above standpt. |
| | | | below standpt. | | | | below standpt. |
| | | | above standpt. | | | | above standpt. |
| | | | below standpt. | | | | below standpt. |

Prepared by: D. Kain

Checked: Noted on U.T.M. Card

S: 2733--1

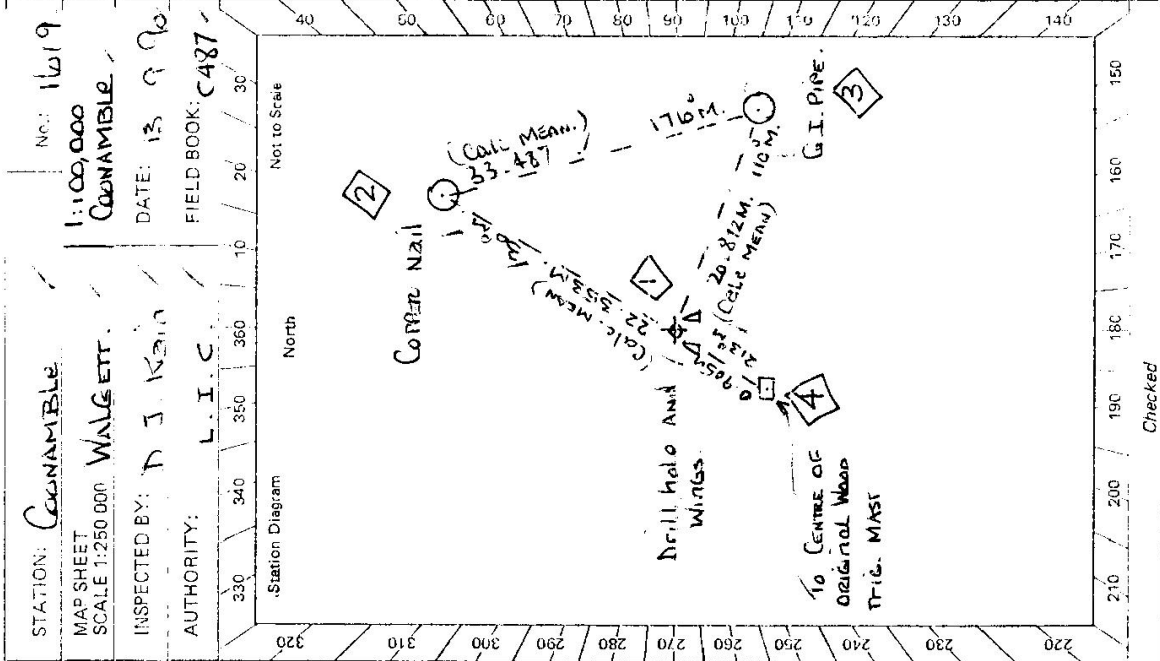


Checked

STATION COOMMABLE TS-1619

Owner's Name: COOMMABLE SHIRE Council Current Occupant:
 Address: Address:
 Phone: (0168) 221 1333 Phone:
 ACCESS 13-9-1990
 Access Report of/19..... was found suitable/unsuitable.

FOR ACCESS, ACCESS LADDER and PERMISSION TO ENTER, OCCUPY ETC. SEE COOMMABLE RESERVOIR PILLAR.

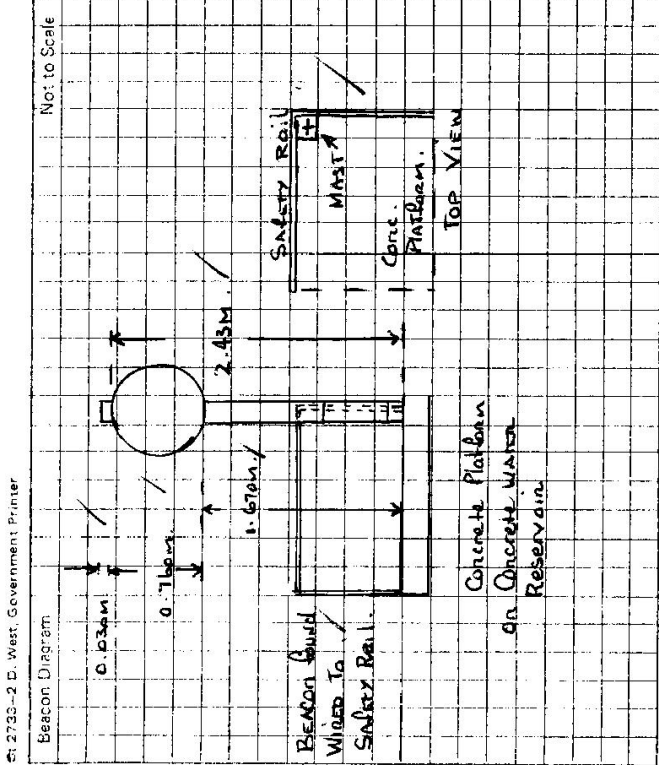

This section to be completed by officer constructing pillar.

Original station mark found/not found.

Description of mark:

Original beacon found/not found.

Description of beacon:

Height: Top of Vanes to Top Mark.....m.

Height of mark.....m. above rock/conc.....m. below G.L.

Diameter of Vanes.....m. Height of Cabrio.....m.

Original Beacon has/has not been destroyed by me.

Date Record of Station

CARD NO 3 OF 3 CARDS No.: 1619

STATION: COGNAMBLE

MAP SHEETS: WALGETT SCALE 1:100 000
SCALE 1:250 000

INSPECTED BY: D. J. Kain DATE: 13/9/90

AUTHORITY: L.I.C. FIELD BOOK: C477

Station Diagram

GEODETTIC STATION RECONNAISSANCE and MAINTENANCE REPORT

3

| STANDPOINT: | | | | STANDPOINT: | | | |
|-------------------|------------------|-----------------|-------------------|-------------|-----------|-----------------|-------------------|
| Mark | Direction | Horiz. Distance | Height Difference | Mark | Direction | Horiz. Distance | Height Difference |
| AERIAL | 0 00 00 | | above standpt | | | | above standpt |
| DRILL Hole & Wire | 105 00 44/20.876 | 24.58 | above standpt | | | | above standpt |
| COPPER NAIL | 145 S4 37/33.486 | 0.200 | below | | | | below |
| | | | above standpt | | | | above standpt |
| | | | below | | | | below |
| | | | above standpt | | | | above standpt |
| | | | below | | | | below |
| | | | above standpt | | | | above standpt |
| | | | below | | | | below |
| STANDPOINT: | | | | STANDPOINT: | | | |
| Mark | Direction | Horiz. Distance | Height Difference | Mark | Direction | Horiz. Distance | Height Difference |
| | | | above standpt | | | | above standpt |
| | | | below | | | | below |
| | | | above standpt | | | | above standpt |
| | | | below | | | | below |
Prepared by: 1619 / 13 / 90

Checked: 1619 / 13 / 90

Noted on U.T.M. Card

LAND INFORMATION CENTRE

GEODETTIC SURVEY OF A.S.W.

Batch 1485

GEODETTIC STATION RECONNAISSANCE and MAINTENANCE REPORT

Description:

Note: Cross out word or words which do not apply

1. Cleared by lanes bearing PERIMITS 360° from Trig. Mast
Steel Pipe Centre of Gal. Iron Roof on Reservoir / 233.9m, 90° Elev., 4 METRES.
2. Mast & Vanes have been painted white & black respectively.
3. The station/pillar was ~~replaced~~ constructed on 18 September 95, dimensions now being: GALVANISED STEEL
Description of mark PILLAR PLATE should be explicit, e.g., S/Steel Pillar-Plate, Steel plug, Brass plug, Bolt, G.I. Pipe
Height of mark 1.355 m. ^{above} ~~rock~~ concrete; Mark is 1.45 m. ^{above} G.L. (Conc. Platform.)
Height of Top Vanes to Top ~~mark~~ mark /Pillar plate 1.430 m. Diameter of Vanes (vertical) 0.15 m.
Height of Cairn m. Diameter of Cairn m. Name Plate ~~found~~ /not found/ placed.
Length of Mast 1.53 m. (~~approximate if not supplied~~)
4. A COPPER NAIL set in conc/rock has been placed/ ~~found~~, bearing 330° M from Mast/Plug/Pillar
5. A G.I. PIPE set in conc/rock has been placed/ ~~found~~, bearing 110° M from Mast/Plug/Pillar
6. A set in conc/rock has been placed/ ~~found~~, bearing ° M from Mast/Plug/Pillar
7. A set in conc/rock has been placed/ ~~found~~, bearing ° M from Mast/Plug/Pillar
8. Action required:

| STANDPOINT: Roof Top Pillar | | STANDPOINT: COPPER NAIL | | | | | |
|-----------------------------|-----------------|-------------------------|-------------------|-----------------|-----------------|-----------------|-------------------|
| Mark | Direction | Horiz. Distance | Height Difference | Mark | Direction | Horiz. Distance | Height Difference |
| AERIAL | 0 00 00 | 1 | above standpt. | AERIAL | 0 00 00 | 0 | above standpt. |
| COPPER NAIL | 185 34 27/22.36 | 26.21 | above standpt. | ROOF TOP PILLAR | 05 22 42/22.35 | 26.21 | above standpt. |
| G.I. PIPE | 287 02 11/20.87 | 26.09 | above standpt. | G.I. PIPE | 321 42 47/33.48 | 36.20 | above standpt. |
| | | | below standpt. | | | | below standpt. |
| | | | above standpt. | | | | above standpt. |
| | | | below standpt. | | | | below standpt. |
| | | | above standpt. | | | | above standpt. |
| | | | below standpt. | | | | below standpt. |

Prepared by: D. Kain Checked: P. G. 13/11/90 Noted on: U.T.M. Card

CARD No. 1 of 2 Cards

STATION: Cornamable Reservoir (P) No: 1619
 MAP SHEET WALGETT 1:100,000
 SCALE 1:250,000
 INSPECTED BY: D. J. Kain DATE: 18.9.90
 AUTHORITY: L.I.C. FIELD BOOK: 487

Station Diagram

Not to Scale

North

Cornamable (Reservoir Pillar)

Checked

TS-1619


STATION COONAMBLE ~~RESERVOIR~~ PILLAR

Owner's Name: COONAMBLE SHIRE Council / Contact: MR HANS POKORRA.
 Address: 30 CASTLEBROUGH STREET, COONAMBLE SHIRE DEPOT.
 SHIRE ENGINEER: MR ALYN ELSTONE
 Phone: (068) 221 333 / Phone: (068) 221 933

ACCESS 18-9-1990

Access Report of was found suitable/unsuitable.

COONAMBLE RESERVOIR PILLAR IS SITUATED ON EASTERN SIDE OF CONCRETE WATER RESERVOIR SITUATED ON CORNER OF BARTON AND YARRAN STREETS, COONAMBLE.

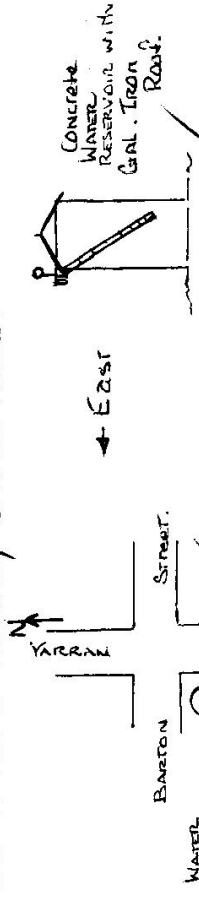


Contact for future visits, permission and access ladder
 Contact Water and Sewerage Foreman, MR. POKORRA.
 MR. POKORRA WILL ASSIST WITH LADDER FOR ACCESS ON SATURDAYS WITH PRIOR NOTICE
 Private Address and Phone No: 13 BROAD ST, COONAMBLE / Phone: (068) 221 091

Record of Station

Date

TS 2733-2 D. West. Government Printer

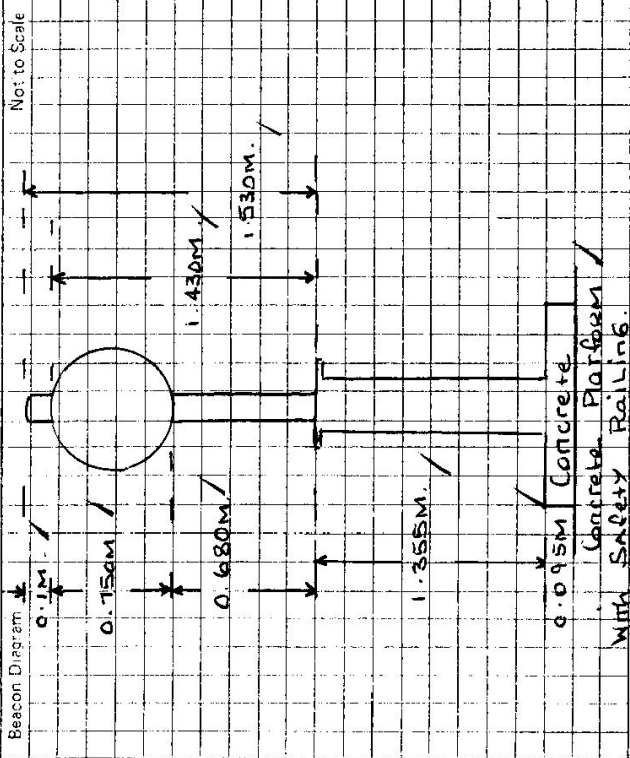

This section to be completed by officer constructing pillar.

Original station mark found/not found.

Description of mark: No MARK

Original beacon found/~~not found~~.

Description of beacon: MAST AND VANE

Height Top of Vane to ~~Top of Mast~~ 2.43 m.

Height of mark: Nil above rock/conc. below G.L.

Diameter of Vane 0.76 m.

Height of Cairn

Original Beacon has/~~not~~ been destroyed by me.

CARD No 2 of 2 CARDS
 STATION: OXNAMBLE RESEARCH (P) No.: 1619
 MAP SHEETS: WALGETT SCALE 1:100 000
 SCALE 1:250 000 OXNAMBLE
 INSPECTED BY: D. J. Kain DATE: 18.9.90
 AUTHORITY: L. I. C. FIELD BOOK: (487)

Station Diagram

GEODETIC STATION RECONNAISSANCE and MAINTENANCE REPORT

| STANDPOINT: C. I. Pipe | | | | STANDPOINT: | | | |
|------------------------|-------------------------|-----------------|-------------------|-------------|-----------|-----------------|-------------------|
| Mark | Direction | Horiz. Distance | Height Difference | Mark | Direction | Horiz. Distance | Height Difference |
| AERIAL | 0 00 00 / | | above standpt. | | | | above standpt. |
| Roof. Top Pillar | 105 01 33 / 20 36 26 08 | | above standpt. | | | | above standpt. |
| COPPER NAIL | 145 55 12 / 33 48 10 22 | | below standpt. | | | | below standpt. |
| | | | above standpt. | | | | above standpt. |
| | | | below standpt. | | | | below standpt. |
| | | | above standpt. | | | | above standpt. |
| | | | below standpt. | | | | below standpt. |
| STANDPOINT: | | | | STANDPOINT: | | | |
| Mark | Direction | Horiz. Distance | Height Difference | Mark | Direction | Horiz. Distance | Height Difference |
| | | | above standpt. | | | | above standpt. |
| | | | below standpt. | | | | below standpt. |
| | | | above standpt. | | | | above standpt. |
| | | | below standpt. | | | | below standpt. |
| | | | above standpt. | | | | above standpt. |
| | | | below standpt. | | | | below standpt. |
| | | | above standpt. | | | | above standpt. |
| | | | below standpt. | | | | below standpt. |

Prepared by: D. Kain Checked: Pick 12/1/90 Noted on U.T.M. Card