

CENTRAL MAPPING AUTHORITY

GEODETIC SURVEY OF A.S.W.

GEODETIC STATION RECONNAISSANCE and MAINTENANCE REPORT

Description:

1. Cleared by lanes bearing *Needs clearing 360* *Note: Cross out word or words which do not apply*
 from Trig. Mast

2. Mast & Vanes have been painted white & black respectively.

3. The station/pillar was ~~unpiled~~/not unpiled/constructed on *19* dimensions now being:

Description of mark *should be explicit, e.g., S/Steel Pillar Plate, Steel plug, Brass plug, Bolt, G.I. Pipe*

Height of mark *m. above below* rock/concrete; Mark is *m. above below* G.L.

Height of Top Vanes to Top Mark/Pillar plate *m. Diameter of Vanes (vertical) m.*

Height of Cairn *1.4 m. Diameter of Cairn 2.5 m. Name Plate found/not found/placed.*

Length of Mast *damaged* *m. (approximate if not unpiled)*

4. A. *set in conc/rock has been placed/found, bearing ° M from Mast/Plug/Pillar*

5. A. *set in conc/rock has been placed/found, bearing ° M from Mast/Plug/Pillar*

6. A. *set in conc/rock has been placed/found, bearing ° M from Mast/Plug/Pillar*

7. A. *set in conc/rock has been placed/found, bearing ° M from Mast/Plug/Pillar*

8. Action required *Requires clearing & rebuilding cairn or pillar*
at 1/2 day.

STANDPOINT:

STANDPOINT:

Mark	Direction	Horiz. Distance	Height Difference	Mark	Direction	Horiz. Distance	Height Difference
			above standpt				above standpt
			below				below
			above standpt				above standpt
			below				below
Prepared by: *A. Patterson* 25/9/19 Checked:

Noted on U.T.M. Card

SI 2723-1

STATION: COONAMBRO No.: 1621
 MAP SHEET SCALE 1:250 000 FORBES
 INSPECTED BY: A. PATTERSON DATE: 11-9-19
 AUTHORITY: C.M.A. FIELD BOOK: A81785

Station Diagram


North

Not to Scale

Checked

61 2733-2 D. West, Government Printer

STATION COONAMBRO TS 1621

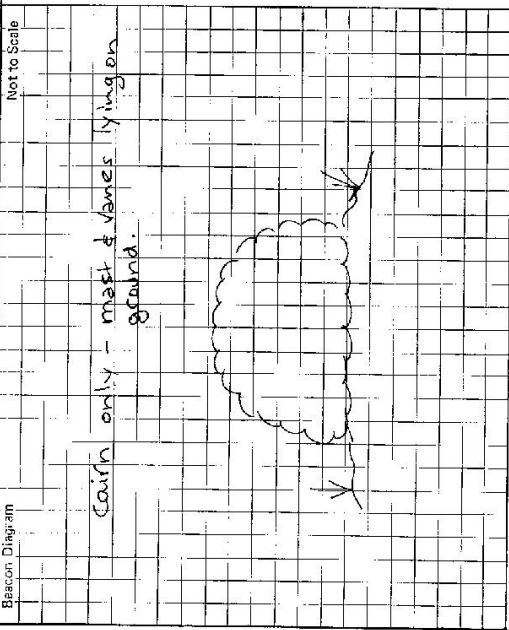

Owner's Name: Roger Good
 Address: "Melba Vale"
PO Box 136 Parkes
 Phone: (068) 621187

Current Occupant:
 Address:
 Phone:

ACCESS
 Access Report of 11.9.1977 was found suitable/unsuitable.

- Access km
- 0.0 Parkes PO head south along Corrajang St
 - 0.5 Turn left into Clairinda St
 - 1.8 Turn right - take road to Cowra
 - 8.0 Cross railway line
 - 9.3 Turn left towards Cookamidgee 8km
 - 16.7 At crossroads - straight ahead towards Murgoo 40 km
 - 17.1 Straight ahead
 - 20.25 Turn right through gate - CMA lock placed
 - 23.0 Station near repeater tower - drive to.

This section to be completed by officer constructing pillar.

Original station mark found/not found.

Description of mark:

Original beacon found/not found.

Description of beacon:

Height Top of Vane to Top Markm.

Height of markm. above G.L. above rock/concm. below

Diameter of Vanem. Height of Cairnm.

Original Beacon has/has not been destroyed by ma.

Date	Record of Station