

CENTRAL MAPPING AUTHORITY

GEODETIC SURVEY OF M.S.M.

GEODETIC STATION RECONNAISSANCE and MAINTENANCE REPORT

Description:

Note: Cross out word or words which do not apply

1. Cleared by lanes bearing..... No lanes from Trig. Mast
2. Mast & Vanes have been painted white & black respectively.
3. The station/~~marker~~ was ~~relocated~~/not unplied/~~consecrated~~ on..... 4-2-1981..... dimensions now being:
 - Description of mark..... should be explicit, e.g., S/Steel Pillar Plate, Steel plug, Brass plug, Bolt, G.I. Pipe
 - Height of mark..... m. ^{above} rock/concrete; Mark is..... m. ^{above} G.L.
 - Height of Top Vanes to Top Mark/Pillar plate..... m. Diameter of Vanes (vertical)..... m.
 - Height of Cairn..... m. Diameter of Cairn..... m. Name Plate found/not found/placed.
 - Length of Mast..... m. (approximate if not unplied)
4. A..... S.S.M...... set in conc/~~rock~~ has been placed/found, bearing..... 315.....°M from Mast/~~plug/pillar~~ Slightly damaged!
5. A..... set in conc/rock has been placed/found, bearing.....°M from Mast/Plug/Pillar
6. A..... set in conc/rock has been placed/found, bearing.....°M from Mast/Plug/Pillar
7. A..... set in conc/rock has been placed/found, bearing.....°M from Mast/Plug/Pillar
8. Action required:..... 2 days to clear 360°.....

STANDPOINT:

STANDPOINT:


Mark	Direction	Horiz. Distance	Height Difference	Mark	Direction	Horiz. Distance	Height Difference
			above standpt.				above standpt.
			below				below
			above standpt.				above standpt.
			below				below
Prepared by: H.G. Heddern

Checked:

Noted on U.T.M. Card

Sr 2733-1

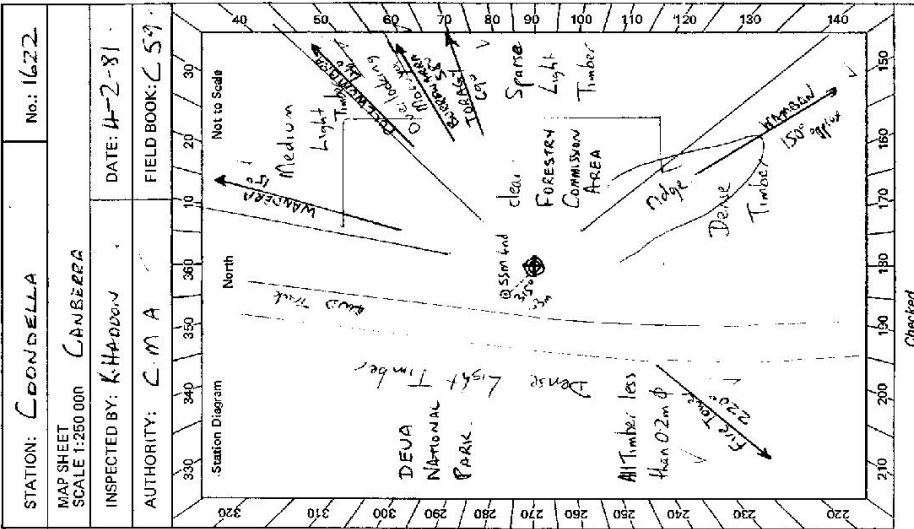

Checked

STATION: COONDELLA No: 1622

MAP SHEET SCALE 1:250 000 CANBERRA

INSPECTED BY: K.HADDON DATE: 4-2-81

AUTHORITY: C.M.A. FIELD BOOK: C.S.9


STATION **COORDINELLA TS-1622**

Owner's Name: **FORESTERN COMMISSION**
 Address: **MAROOMA OFFICE**
 Phone:

Current Occupant:
 Address:
 Phone:

ACCESS

- Access Report of 4/2/1981 was found suitable/unavailable.
- 0-0 MORUYA COURT HOUSE Head south along VULCAN ST.
 - 0-2 Turn right
 - 0-4 MORUYA POST OFFICE on right
 - 3-5 Turn left towards "WOMBAND"
 - 5-1 Bridge
 - 6-0 Take road to right towards DOMALOS CREEK
 - 7-5 Take road to left.
 - 7-8 Sign on right "MUNGERABIE STATE FOREST"
 - 7-9 Follow main road to left
 - 9-8 Follow main road to left
 - 10-4 Follow main road to right
 - 12-6 Follow main road to left.
 - 14-9 Ford. Thenne follow track to left.
 - 15-0 Gate.
 - 15-1 Take track to right.
 - 15-2 Pass house.
 - 15-4 Gate
 - 16-3 Turn left. Old sign on tree "Coonidella"
 - 16-9 Sign on right "DEVA NATURAL PARK"
 - 19-9 Pass track on left. Sign on right "DEVA NATURAL PARK"
 - 24-2 At trig located on east side of track.

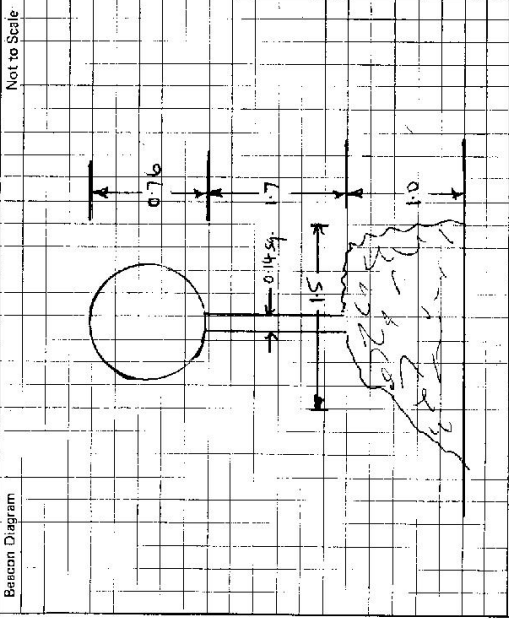

Not to Scale

Beacon Diagram

This section to be completed by officer constructing pillar.

Original station mark found/not found.
 Description of mark:
 Original beacon found/not found.
 Description of beacon:
 Height Top of Vane to Top Markm.
 Height of markm. above G.L. below
 Diameter of Vanem. Height of Cairnm.
 Original Beacon has/has not been destroyed by me.

Record of Station

Date