

GEODETTIC SURVEY OF N.S.W.

CENTRAL MAPPING AUTHORITY


GEODETTIC STATION RECONNAISSANCE and MAINTENANCE REPORT

STATION: *Cooper* No.: *1624*

MAP SHEET SCALE 1:250 000 *Canberra*

INSPECTED BY: *P.L. BARNOLA* DATE: *April 1979*

AUTHORITY: *C.M.A* FIELD BOOK:

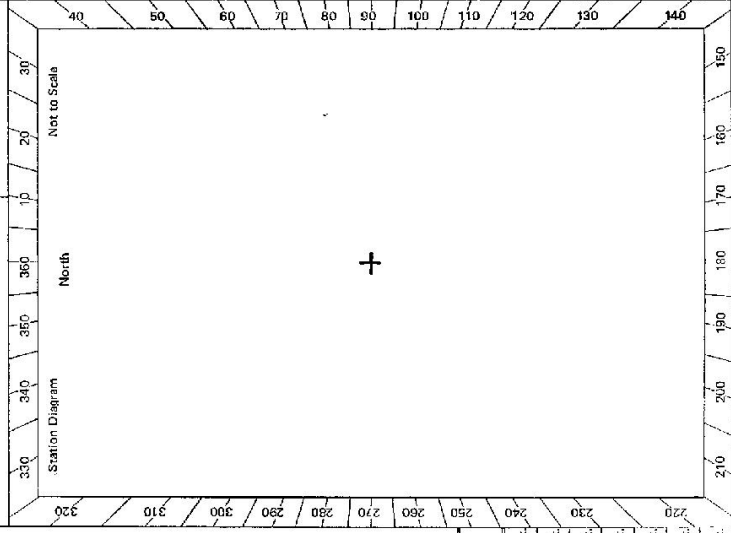

- Description:
- Cleared by lanes bearing. *Note: Cross out word or words which do not apply*
 - Mast & Vanes have been painted white & black respectively.
 - The station/pillar was ~~unplaced~~/~~constructed on~~ *found* *Keop of Rocks* *found* *should be explicit, e.g., Steel/Pillar/Plate; Steel plug; Brass plug; Bolt; G.T. Pipe*
 - Height of mark *above* *below* *rock/concrete*; Mark is *above* *below* *G.L.*
 - Height of Top Vanes to Top Mark/Pillar plate *m.*; Diameter of Vanes (vertical) *m.*
 - Height of Cairn *m.*; Diameter of Cairn *m.*; Name Plate found/not found/placed.
 - Length of Mast *m.* (approximate if not unplaced)
 - A *set* in conc/rock has been placed/found, bearing *°M* from Mast/Plug/Pillar
 - A *set* in conc/rock has been placed/found, bearing *°M* from Mast/Plug/Pillar
 - A *set* in conc/rock has been placed/found, bearing *°M* from Mast/Plug/Pillar
 - A *set* in conc/rock has been placed/found, bearing *°M* from Mast/Plug/Pillar
 - Action required:

STANDPOINT:

Mark	Direction	Horiz. Distance	Height Difference	Mark	Direct on	Horiz. Distance	Height Difference
			<i>above</i> <i>standpt.</i>				<i>above</i> <i>standpt.</i>
			<i>below</i> <i>standpt.</i>				<i>below</i> <i>standpt.</i>
			<i>above</i> <i>standpt.</i>				<i>above</i> <i>standpt.</i>
			<i>below</i> <i>standpt.</i>				<i>below</i> <i>standpt.</i>
			<i>above</i> <i>standpt.</i>				<i>above</i> <i>standpt.</i>
			<i>below</i> <i>standpt.</i>				<i>below</i> <i>standpt.</i>
			<i>above</i> <i>standpt.</i>				<i>above</i> <i>standpt.</i>
			<i>below</i> <i>standpt.</i>				<i>below</i> <i>standpt.</i>

Prepared by: *P.L. Barnola* 27/5/79 Checked: *Checked*

STATION <i>Cooper TS 1624</i>	Owner's Name: Address: Phone:	Current Occupant: Address: Phone:	
Access Report of <i>April 1979</i> was found suitable/unsuitable. <i>Refer Lake Bathurst 1:25000 Sheet</i>		ACCESS	
Not to Scale		This section to be completed by officer constructing pillar. Original station mark found/not found. Description of mark: Original beacon found/not found. Description of beacon: Height Top of Vanes to Top Mark: m. Height of mark: m. above rock/conc m. below G.L. Diameter of Vanes m. Height of Cairn m. Original Beacon has/has not been destroyed by me.	
Date		Record of Station	

St 2733-2 D. West, Government Printer