

LAND INFORMATION CENTRE

GEODETIC SURVEY OF N.S.W.

GEODETIC STATION RECONNAISSANCE and MAINTENANCE REPORT

STATION: **COOTAMUNDRA**

No.: **1633**

Description:

- Cleared by lines bearing $35^\circ - 115^\circ$; $180^\circ - 200^\circ$; $320^\circ M - 20^\circ M$ from Trig. Mast
Note: Cross out word or words which do not apply
- Mast & Vanes have been painted white & black respectively
- The station/pillar was unpiled/~~not unpiled~~/~~constructed~~ on ~~NOT KNOWN~~ 19....., dimensions now being:
Description of mark **TRIG. PLUG**..... should be explicit, e.g., S/Steel Pillar Plate, Steel plug, Brass plug, Bolt, G.I. Pipe
Height of mark.....m. ^{above} rock/concrete; Mark is ~~at~~.....m. ^{above} G.L.
Height of Top Vanes to Top Mark/Pillar plate ~~N/A~~.....m. Diameter of Vanes (vertical).....m.
Height of Cairn.....m. Diameter of Cairn.....m. Name Plate found/not found/placed.
Length of Mast.....m. (approximate if not unpiled)
- A. **NIL F.D.**.....set in conc/rock has been placed/found, bearing.....°M from Mast/Plug/Pillar
- A.....set in conc/rock has been placed/found, bearing.....°M from Mast/Plug/Pillar
- A.....set in conc/rock has been placed/found, bearing.....°M from Mast/Plug/Pillar
- A.....set in conc/rock has been placed/found, bearing.....°M from Mast/Plug/Pillar
- Action required:.....

STANDPOINT:

Mark	Direction	Horiz. Distance	Height Difference	Mark	Direction	Horiz. Distance	Height Difference
			above standpt.				above standpt.
			below				below
			above standpt.				above standpt.
			below				below
Prepared by: *Abba - 29/7/96*

Checked:

Noted on U.T.M. Card

Checked


MAP SHEET
SCALE 1:250 000

INSPECTED BY: **R. ELLIS**

DATE: **8/7/96**

AUTHORITY: **LAND INFORMATION CENTRE**

FIELD BOOK: **N/A**

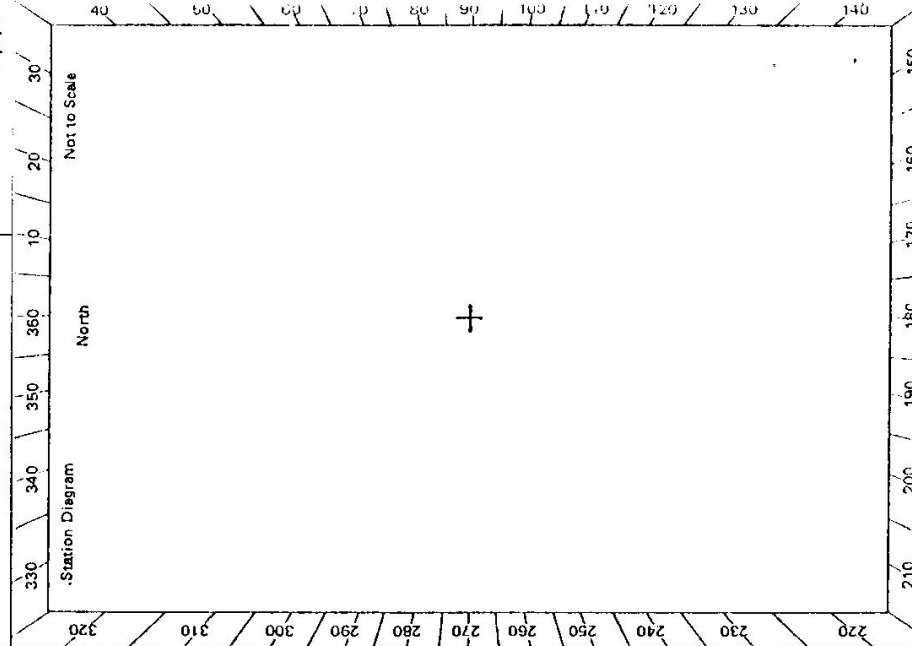

TS 2733-2 D. West, Government Printer

STATION **COOTAMUNDRA . TS 1633**

Owner's Name:
 Address:
 Phone:
 Current Occupant:
 Address:
 Phone:

ACCESS

Access Report of/19.....was found suitable/unsuitable.

Beacon Diagram	Not to Scale
GPS 1254 plot	
#E	
35 - 115° M Clear	
115 - 180° M (10 TREES)	
180 - 200 Clear	
200 - 215 1 Box tree	
215 - 240 Scattered timber	
240 - 320 Ridge	
320 - 20 Clear	
20 - 35 1 Kurrajong	
122° Mt Yamina Hill	
200 Wanda Hill	
16 Tingalee (P)	
51 Cullinana (P)	
92 Trig ??	

This section to be completed by officer constructing pillar.

Original station mark found/not found.

Description of mark:

Original beacon found/not found.

Description of beacon:

Height Top of Vanes to Top Markm.

Height of markm. above rock/concm. below above G.L.

Diameter of Vanesm. Height of Cairnm.

Original Beacon has/has not been destroyed by me.

Date	Record of Station
29/7/96	Trig fine for GPS but unsuitable for pillar etc as not visible. Access OK: Cairn was not repiled. Mast vanes are unsuitable.