

STATION TS. C REEN 1643

Owners Name... DEPT. OF LANDS

Current Occupant.....



Address..... T.R. 1113

Address.....

Station Diagram

Not to Scale

North

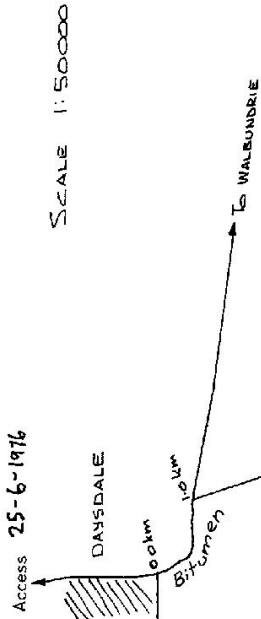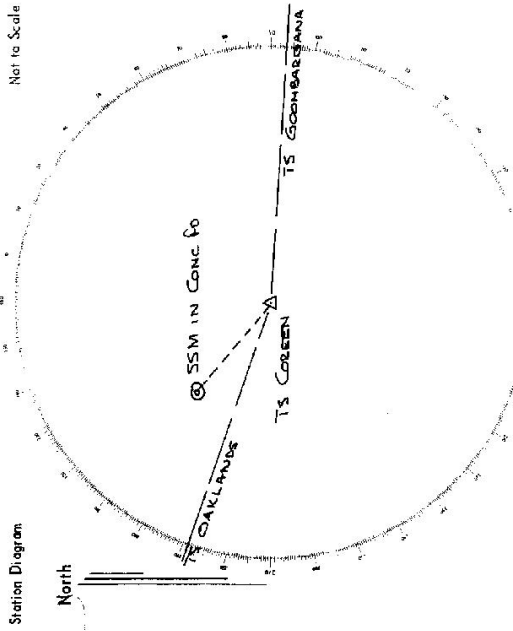

STATION SUMMARY LOCAL ORIENTATION

STATION OCCUPIED 124 13 CORRECTION 0.47E 2276.77E
 FIELD BOOK 271 PAGE 23 OBSERVER R MOORE RECORDED EGGLESTON
 LOCALITY TS. COOREEN ROAD R.P.P.

STATION	BEARING	DISTANCE	R.L.
121 TS COORBARANA	52 45 54.2	253.128	
122 TS CALLANGS	259 12 15.5	24842.315	45.562
123 @ SSM IN CONC PO	294 55 32.1		164.538
124 SSM 21913	274 22 54.8	27716.362	124.238
125 SSM 14 039C	309 45 23.3	1.518	0.155

D. West. Government Printer, New South Wales - 1976


STATION 1643 COREEN TS

Owners Name..... Current Occupant.....

Address.....

3-6-1977
 OAKLANDS 1150 000.

At DAYSPALE TRAVEL SOUTH ON THE URANA - CORUWA ROAD
 4.0 KM TURN LEFT ONTO HARRISONS ROAD
 FOLLOW THIS ROAD FOR 6 KMS TO TS ON ROAD

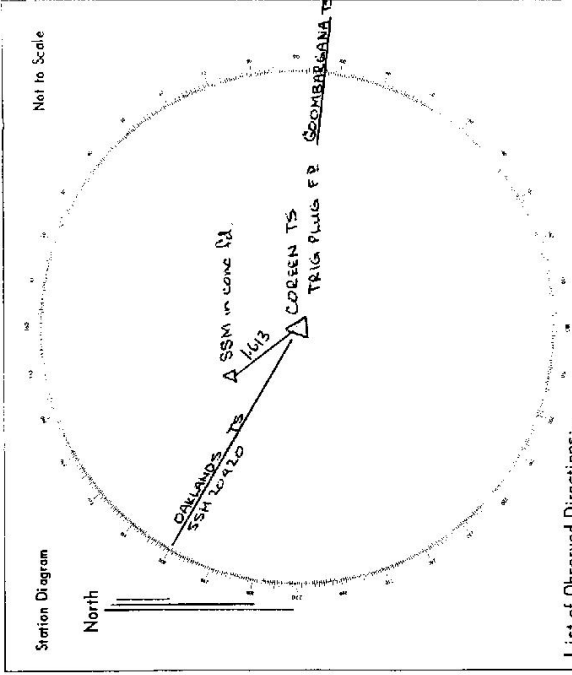

List of Observed Directions:-

Station: TRIG PLUG		Standpoint: TRIG PLUG	
Station	Direction	Station	Direction
OAKLANDS TS	0°00'00"	SSH 20420	0°00'00"
OAKLANDS TS	195°26'12.0"	OAKLANDS TS	1°51'25.5"
		SSH in conc ID	22°19'42"
Station	Direction	Station	Direction